

WATER SERVICE RECORD

Name John Casold, Inc.

Service No. #35

Address 5 Suzanne Road

Location

~~Request Renewal~~ New Service WO #7174

Comm 6-25-62


Date	Material	Amount	Total	Date	Amount	
4-25-62	Labor	12.28		4-23-62	Deposit	100.00
4-26-62	"	15.04	27.32	6-25-62	Paid by WHT #34	15.48
	10% O.H.	2.73	30.05			115.48
	80' 3/4" Copper tubing @ .42		33.60			
	1 3/4" C x 1/2 I.W.H. Stop & Waste	6.17			Non-Charge	
	1 3/4" C3 Part Union		2.41	4-25-62	Labor	8.20
	21 X 3 Patch		21.00	24	3/4" Copper tubing @ .42	10.08
	2 1/2 Hrs. Town Shovel @ 6.50		16.25	1	3/4" C Corp Cock	4.91
	2 Hrs. Trucking @ 3.00		6.00	1	3/4" C Curb Cock	6.28
			115.48	1	Box & Rod	4.90
				1/2	Hr. Trucking @ 3.00	1.50
				1/2	Hr. Town Shovel @ 6.50	3.25
						39.12

DATE _____

TOWN OF LEXINGTON — BOARD OF PUBLIC WORKS

WATER DIVISION

Sketch of Service Here

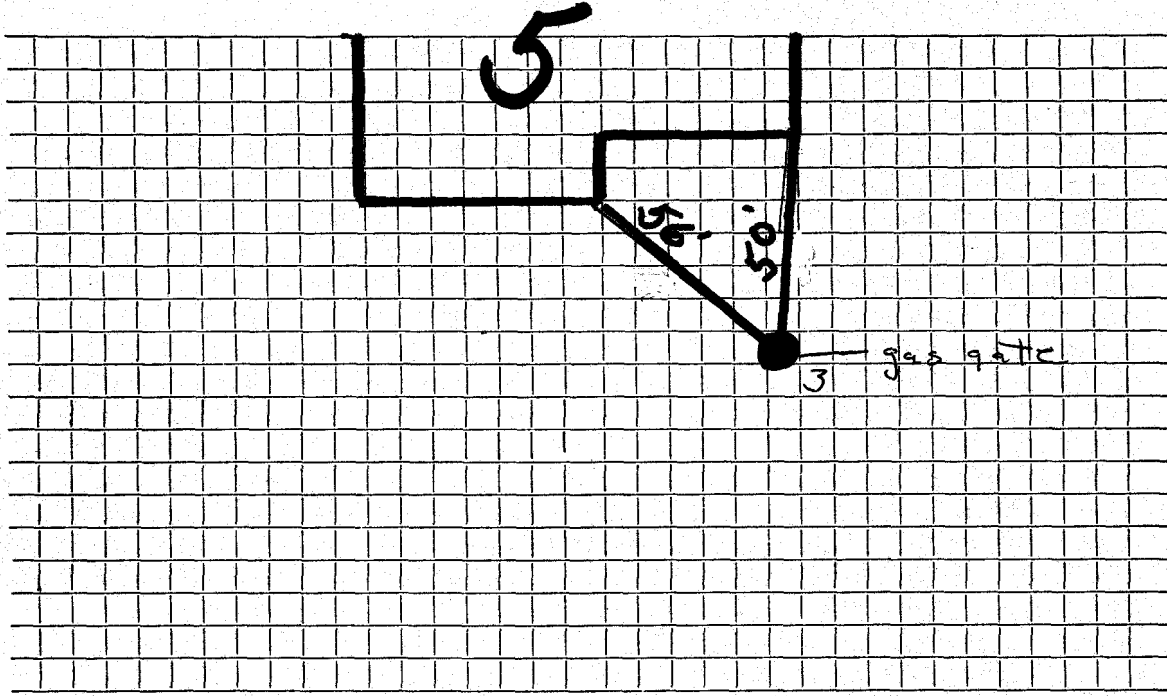

Connection made in Street. Work completed

Remarks:
.....
.....