

**WATER SERVICE RECORD**

**Name**

**Service No.**

**Address** 6 Suzanne Road

# 2156

**Location** 6 SUZANNE RD

~~REPAIR CHARGE~~ **New Service SERVICE BY BUILDER**


Date	Material	Amount	Total	Date	Amount
57' 3/4"	Copper tubing @.42		20.74		
					<b>NON CHARGE</b>
				1-3-58	Labor 4.17
					16' 3/4" Copper tubing @.37 5.92
					1 3/4" C Corp Cock 4.64
					1 3/4" C Gurb Cock 6.03
					1 Box & Rod 5.00
					1 hr. Trucking .75
					<u>26.51</u>

DATE \_\_\_\_\_

TOWN OF LEXINGTON — BOARD OF PUBLIC WORKS

**WATER DIVISION**

Sketch of Service Here

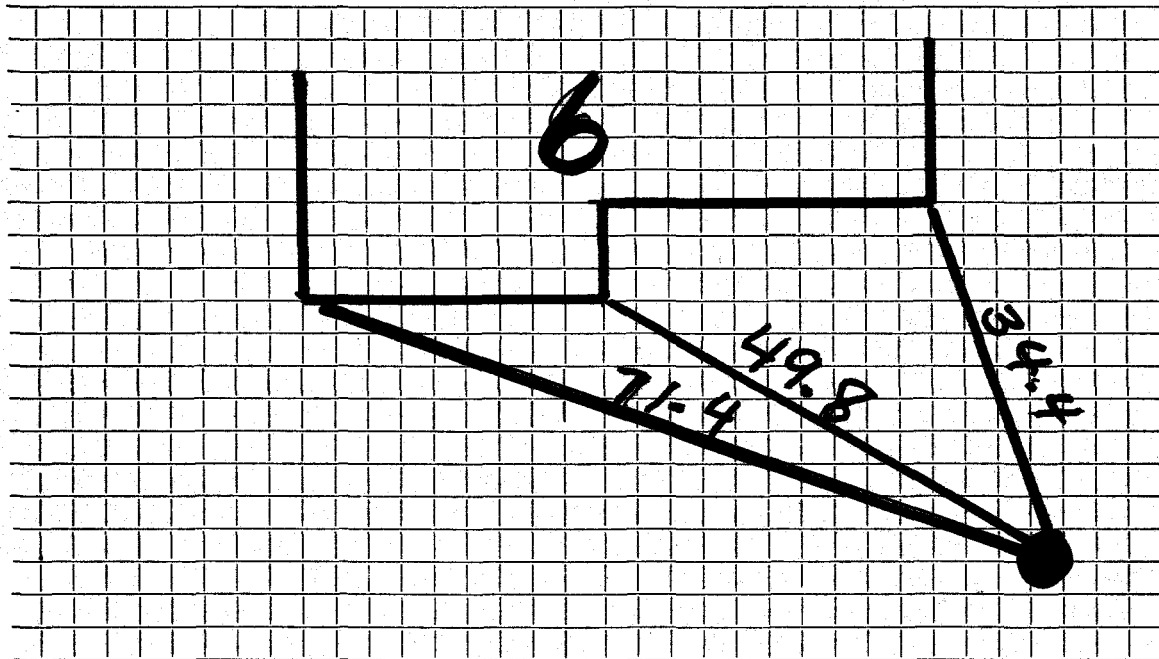

Connection made in ..... Street. Work completed .....

Remarks: .....

.....

.....