

WATER SERVICE RECORD

4428

Name John Castoldi

Service No. 98

Address 7 Suzanne Road

Location Lot 4

Repair—Renewal—New Service

WO # 7495


Comm. 10-29-62

Date	Material	Amount	Total	Date	Amount	
8/22/62	Labor	23 82		7-30-62	Deposit	100 00
	10% O.H.	2 38		10-29-62	ReFund	3 62
			26 20			96 98
	110' 3/4" copper tubing @ .42	46 20			NON CHARGE	
	1 3/4" Cx 1/2 IWH Stop & Waste	6 17		1/3/58	Labor	4 17
	1 3/4" C 3 part Union	2 41			27' 3/4" Copper tubing @ .37	9 99
	2 hrs. Town shovel @ 6.50	13 00			1 3/4" C Corp Cock	4 64
	1 hr. trucking @ 3.00	3 00			1 3/4" C Curb Cock	6 03
			96 98		1 Box & Rod	5 00
					1 Hour Trucking @ .75	75
					1 1/2 straight tail piece	30 58
					1 1/2 offset tail piece	50
						31 58

TOWN OF LEXINGTON — BOARD OF PUBLIC WORKS

WATER DIVISION

Sketch of Service Here

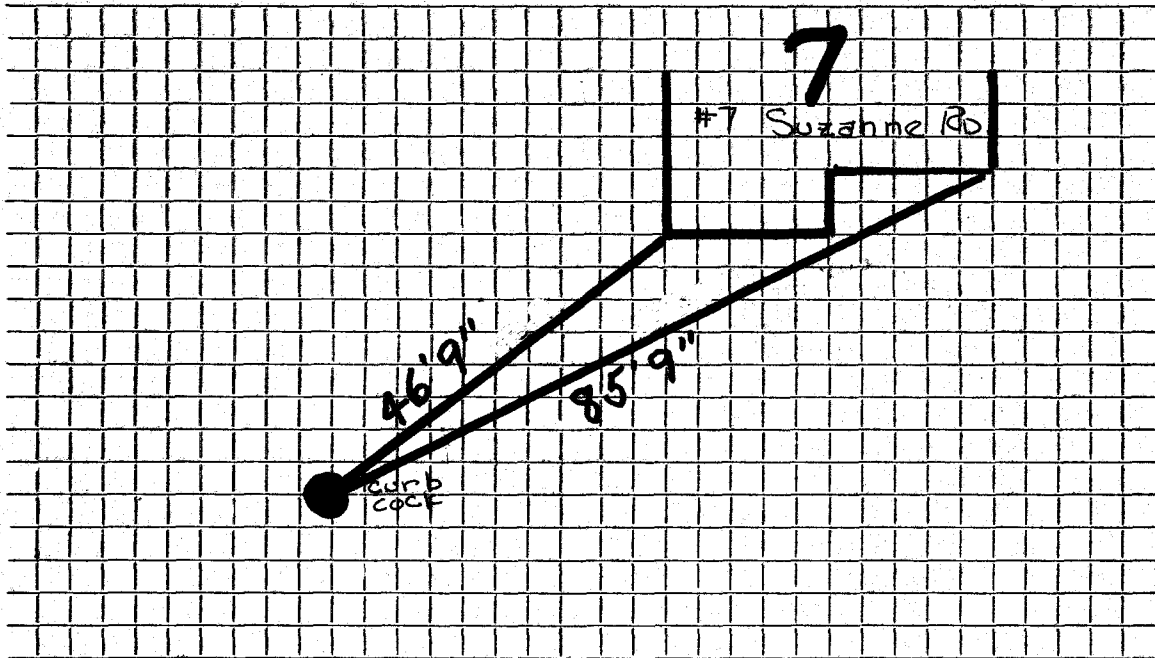

Connection made in Street. Work completed

Remarks:

.....

.....