

Name

Service No. 2609

Address

11 Swan Lane

Location

11 Swan Lane # 2161

Kind of Pipe

Size

Size of Main

Repair—Renewal—New Service

Location

Date No Charge	Material	Amount	Total	Date	Location	Amount
2/25/77	Inside W.O. #5269					
	Labor					
	47' 3/4" Copper tubing					
	1 3/4" Wheel Stop & Waste				OUTSIDE W.O. #326	
	1 3/4" x 5/8" Reducer			4-6-79	Labor	
	1 3/4" x 1" Iron to Copper				10' 3/4" Copper tubing	
	1 1" x 6" Nipple				1 3/4" Corp	
	2 hrs. Trucking				1 3/4" Curb Cock	
	2 hrs. Compressor				1 3/4" 3 part union	
	1 hr. Town Shovel				1 box & rod	
					1 hr. trucking	
	Labor					

Hadley Press, Inc., Lexington

DATE \_\_\_\_\_

# TOWN OF LEXINGTON—BOARD OF PUBLIC WORKS

## WATER DIVISION

The undersigned applies for a supply of water at No. \_\_\_\_\_ St. and hereby agrees to comply with the rules and regulations as now, or at any future time, established by the Board of Selectmen.

Am't. of Estimate \$ \_\_\_\_\_

Owner

Ernest Arnault


Am't. Paid \$ \_\_\_\_\_

Address

11 Swan Lane

Builder \_\_\_\_\_

Sketch of Service Here

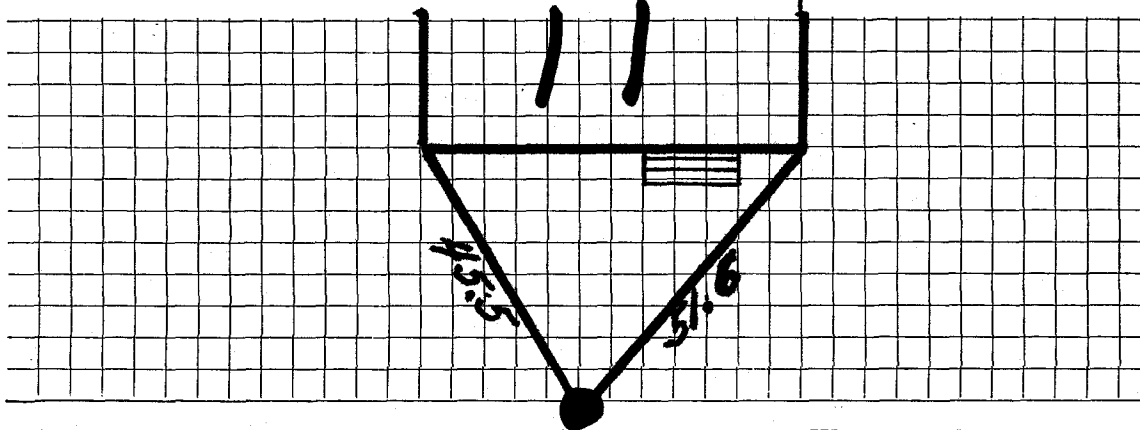

Connection made in \_\_\_\_\_ Street.

Work completed \_\_\_\_\_ 19

Remarks: