

Name Moore Const. Co.

Service No. 204563

Address 16 Swan Lane

Lexington, Mass.

Location 16 Swan Lane

Kind of Pipe

Size

Size of Main

~~Repair~~ ~~Renewal~~ - New Service

Location

Date

Material

Amount

Total

Date

Amount

Date	Material	Amount	Total
Sept. 30, '48	Labor	1 25	1 25
	10% Overhead		13
	60' - 3/4" Copper Tubing @ .255	15 30	15 30
	1 - 3/4" C x 1/2" I.W.H. S&W	3 15	3 15
	Trucking 1 hr. @ .75		75
			20 58

Com. 10/25/48

trench dug by owner.

Labor

Date	Material	Amount
Sept. 27, '48	Deposited	35 00
Sept. 27, '48	Returned	
	Non-Charge	20 58
Sept. 30, '48	Labor	5 05
	20' - 3/4" Copper Tubing @ .255	5 10
	1 - 3/4" C Corp-cock	3 00
	1 - 3/4" C x 3/4" C Curb-cock	3 68
	1 - Box & Rod	3 55
	1 - 1/2" Offset Tail Piece	30
	1 - 1/2" Straight Tail Piece	30
	Shovel 2 hrs. @ 7.00	14 00
	Trucking 1 hr. @ .75	75
		35 73

DATE \_\_\_\_\_

# TOWN OF LEXINGTON—BOARD OF PUBLIC WORKS

## WATER DIVISION

The undersigned applies for a supply of water at No. \_\_\_\_\_ St. and hereby agrees to comply with the rules and regulations as now, or at any future time, established by the Board of Selectmen.

Am't. of Estimate \$ \_\_\_\_\_


Owner \_\_\_\_\_

Am't. Paid \$ \_\_\_\_\_

Address \_\_\_\_\_

Builder \_\_\_\_\_

Sketch of Service Here

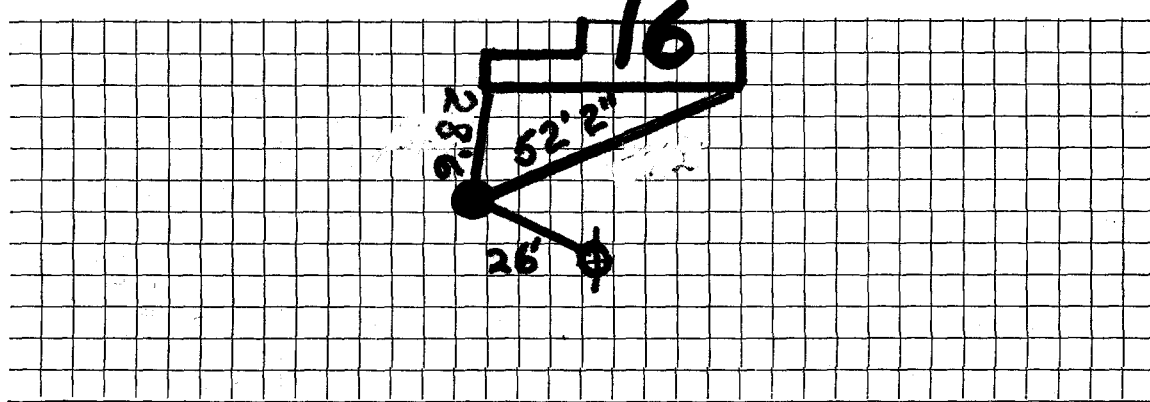

Connection made in SWAN LA. Street.

Work completed \_\_\_\_\_ 19

Remarks: