

Name Arthur W. Richardson (Deposit made by Alice E. Miller Service No. ~~52~~ 2401  
 same address.

Address 38 Bradbury St., Cambridge

# 431

17 Swan Lane

4-25-56 - Now 17 Swan Lane  
 Location #1 Rockville Avenue, cor Swan Lane

Kind of Pipe

Size

Size of Main

Repair—Renewal—New Service

Location

| Date         | Material                                | Amount | Total        | Date          | Amount       |
|--------------|---|--------|--------------|---------------|--------------|
| July 7, 1937 | 2 hrs. @ .60                            |        | 1 20         | June 29, 1937 | 19 50        |
|              | Overhead                                |        | 12           | July 27, 1937 | 2 50         |
|              | 34' $\frac{3}{4}$ " Copper Tubing @ .25 |        | 8 50         |               | <u>17 00</u> |
|              | 1 $\frac{3}{4}$ " Stop and Waste        |        | 3 75         |               |              |
|              | 2 hrs. Trucking @ .75                   |        | 1 50         |               |              |
|              |   |        | <u>15 07</u> |               |              |
|              | Flat Rate 34' @ .50                     |        | 17 00        |               |              |
|              |   |        | <u>17 00</u> |               |              |
|              | Labor                                   |        |              |               |              |

Deposited  
 Refunded.

Hadley Press, Inc., Lexington

39'  
50  
19.50

DATE June 29, 1937

# TOWN OF LEXINGTON—BOARD OF PUBLIC WORKS

## WATER DIVISION

Rockwell Ave. In Swan Lane,  
Rockland St. and hereby agrees to

The undersigned applies for a supply of water at No. 1 Rockland St. and hereby agrees to comply with the rules and regulations as now, or at any future time, established by the Board of Selectmen.

Am't. of Estimate \$ 19.50

Owner Arthur St. Richardson


Am't. Paid \$ \_\_\_\_\_

Address 38 Bradbury St.

Builder \_\_\_\_\_

Cambridge,

Sketch of Service Here

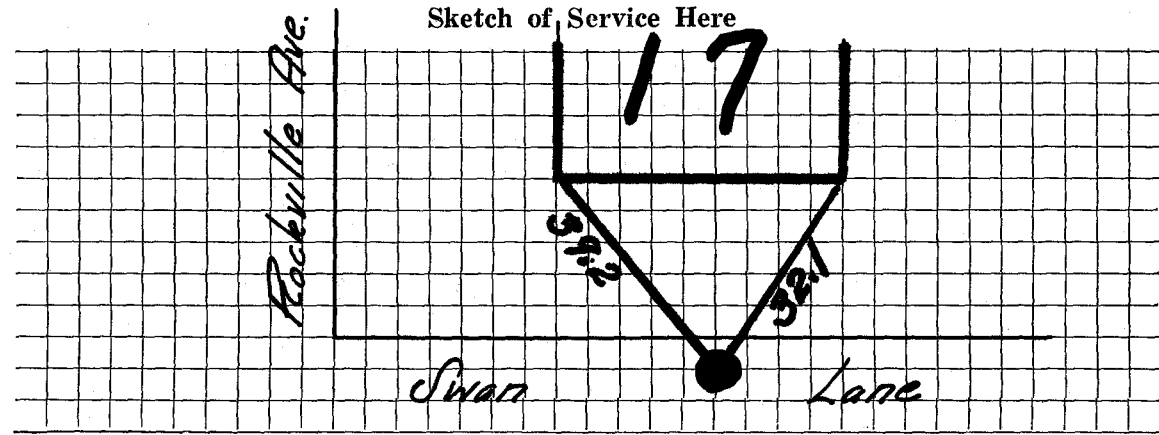

Connection made in \_\_\_\_\_ Street.

Work completed \_\_\_\_\_ 19

Remarks: