

Name Donald Tucker

Service No.

197

Address 24 Swan Lane

2989

Lexington, Mass.

Location

Kind of Pipe

Size

Size of Main

~~Repair-Renewal~~ - New Service

Location

Date	Material	Amount	Total	Date	Amount
Oct. 19, '48	Labor	2 50	2 50	Sept. 9, 1948	35 00
	10% Overhead		25	Dec. 31, '48	7 90
	75&-3/4" Copper Tubing @ .255	19 13			27 10
	1-3/4" C x 1/2" I.W.H. S&W		3 15	Sept. 17, '48	11 60
	1-3/4" C x 3/4" C. Union (3 pts)	1 32		17'-3/4" Copper Tubing @ .255	4 34
	1 hr. Trucking		75	1-3/4" C. Corp-cock	3 00
			27 10	1-3/4" C x 3/4" C. Curb-cock	3 68
				1-Box & Rod	3 55
				1-1/2" Straight Tail Piece	30
	trench dug by owner			1-1/2" Offset Tail Piece	30
				1 Hr. Trucking	75
					27 52
	Labor				

DATE _____

TOWN OF LEXINGTON - BOARD OF PUBLIC WORKS

WATER DIVISION

The undersigned applies for a supply of water at No..... St. and hereby agrees to comply with the rules and regulations as now, or at any future time, established by the Board of Selectmen.

Am't of Estimate \$.....

Owner


Am't Paid \$.....

Address

Builder

.....

Sketch of Service Here

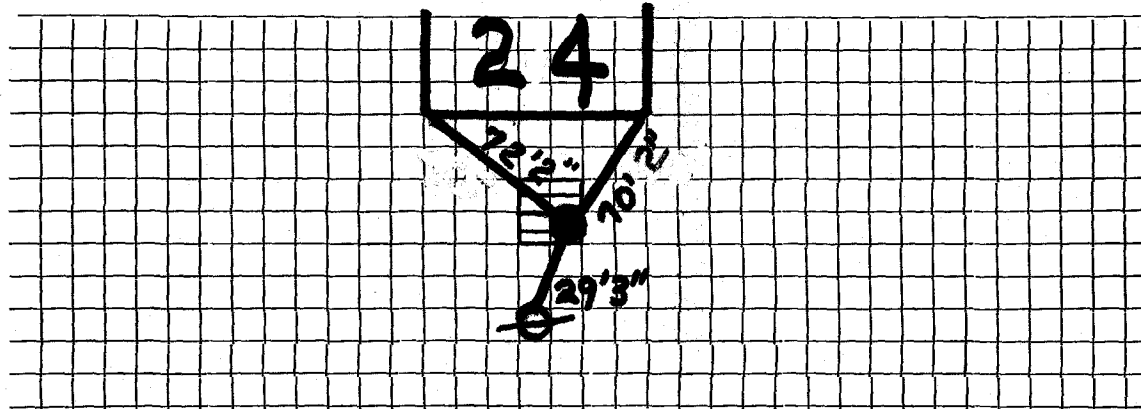

Connection made in Street.

Work completed19

Remarks: