

ENGINEER DDD

WATER SERVICE RECORD

Name Frederick Ridd

Service No. 268

Address 25 Swan Lane

3321

Location

~~REPAIR WORK~~ New Service

Comm. 12-13-54

Date	Material	Amount	Total	Date	Amount
10/30/54	Labor	6 90		10-21-54 Deposited	50 00
	10% overhead	69	7 59	12-20-54 Paid	1 11
	63' -3/4" copper tubing @ .35	22 05			<u>51 11</u>
	1 - 3/4" C x 1/2 I.W.H. stop & waste	4 00			<u>NON CHARGE</u>
	1 - 3/4" C. union	1 72		10/30/54 Labor	23 40
	2 hrs. Littlefield shovel @ 7.50	15 00		12' - 3/4" copper tubing @ .35	4 20
	1 hr. trucking	75		1 - 3/4" C. corp-cock	4 33
			51 11	1 - 3/4" C. curb-cock	4 67
				1 box. and rod	3 90
				1 - 1/2 offset tail pc.	50
				1 - 1/2 straight tail piece	50
				2 hrs. Littlefield shovel @ 7.50	15 00
				1 hr. trucking	75
					<u>57 25</u>


Bill sent 12-14-54

DATE _____

TOWN OF LEXINGTON — BOARD OF PUBLIC WORKS

WATER DIVISION

Sketch of Service Here

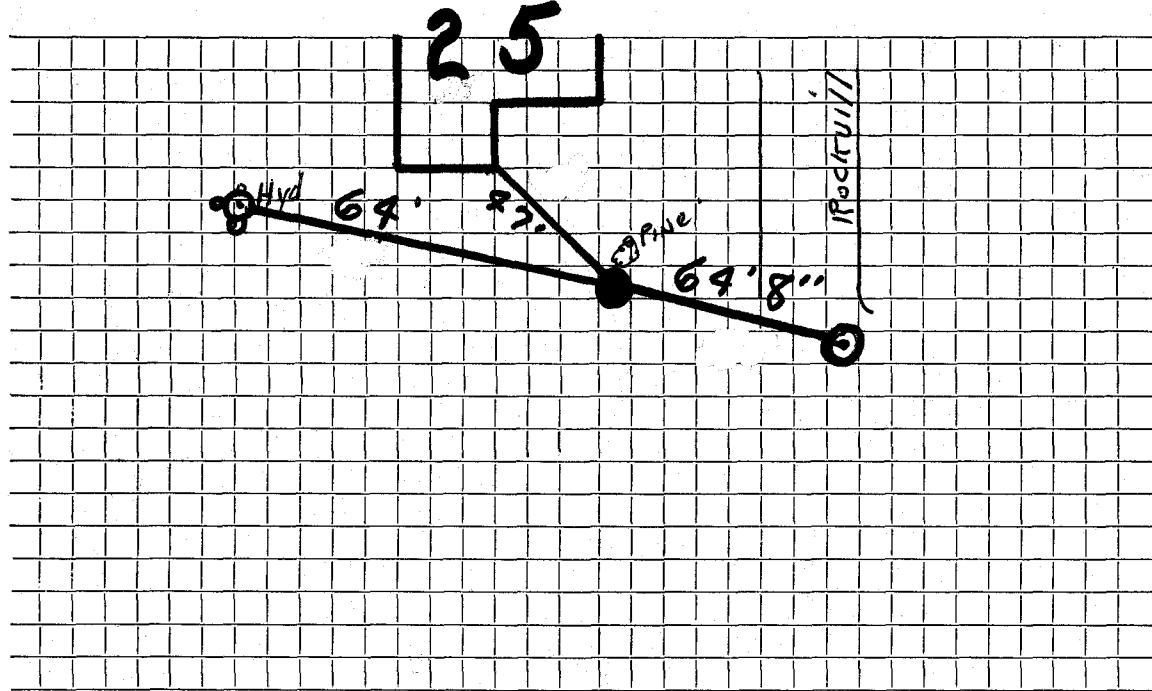

Connection made in Street. Work completed

Remarks:

.....

.....