

WATER SERVICE RECORD

1487
Service No. 108

Name David Harrington

Address 10 Sylvia Street

Location

Renewal

~~XXXXXXXXXXXXXXXXXXXX~~ W.O. #8221

Comm 2-10-64


Date	Material	Amount	Total	Date	Amount
10-8-63	Labor	6.93		10-2-63	Deposit 50.00
	10% O.H.	.69	7.62	2-10-64	Refund 25.65
18'	3/4" Copper Tubing @.42		7.56		24.35
1	3/4" C x 1/2 I.W.H. Stop & Waste		6.17		NON CHARGE
1	hr. Trucking @3.00		3.00	10-8-63	Labor 71.85
			24.35	28'	3/4" Copper tubing @.42 11.76
				1	3/4" C Corp Cock 4.91
				1	3/4" C Curb Cock 6.28
				1	Box & Rod 4.90
				1	1/2 Straight tailpiece .50
				1	1/2 Offset tailpiece .50
				1	hr. Town Shovel @6.50 6.50
				1	hr. Trucking @3.00 3.00
				23	x 3 Patch 23.00
					133.20

DATE _____

TOWN OF LEXINGTON — BOARD OF PUBLIC WORKS

WATER DIVISION

Sketch of Service Here

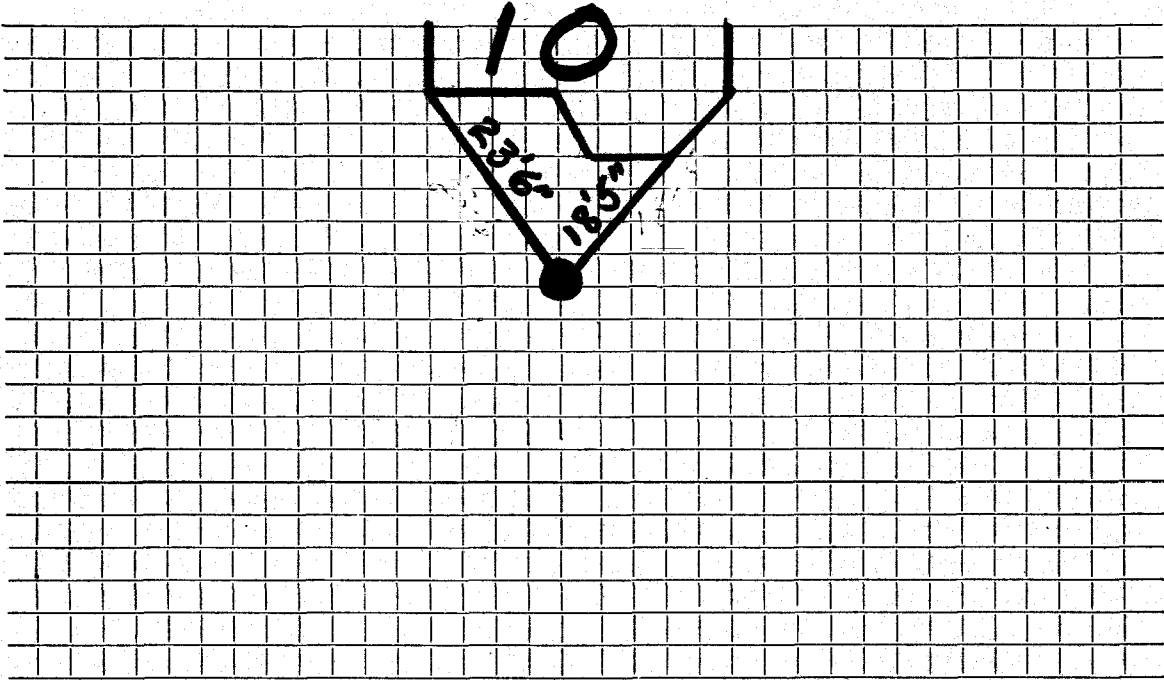

Connection made in Street. Work completed

Remarks:
.....
.....