

WATER SERVICE RECORD

Name Katherine F. Brenner

Service No. 19

Address 11 Sylvia Street

Location

~~Renewal~~—Renewal—~~New Service~~ W.O. #883

NOV 19 1973


Date		Material	Amount	Total	Date	Amount
5/30/73		Labor	51.27		5-30-73	Deposit 120.00
		10% O.H.	5.13	56.40	11-15-73	Retired 16.40
	35'	3/4" Copper @.60/ft.		21.00		OUTSIDE 183.50
	1	3/4" x 1/2" Stop & waste		9.30	5/30/73	Labor 85.45
	12'	1/2" Copper @.47/ft.		5.64	6/15/73	" 44.05
	1	1/2" Elbow		.15	16'	3/4" Copper @.60 9.60
	1	1/2" C Adaptor		.44	1	3/4" Corporation 7.42
	1	1 1/2" Elbow		.29	1	3/4" Curb Stop 11.32
	1	1/2" x 1/2" C.I.		.48	1	Box & Rod 7.34
	1	hr. Town Shovel		6.50	4	hrs. Trucking @3.00 12.00
	1	hr. Trucking		3.00	1	hr. Compressor 5.00
		TOTAL CHARGE:		103.20	1	hr. Roller 2.00
						TOTAL NON-CHARGE: \$ 184.18

DATE _____

TOWN OF LEXINGTON — BOARD OF PUBLIC WORKS

WATER DIVISION

Sketch of Service Here

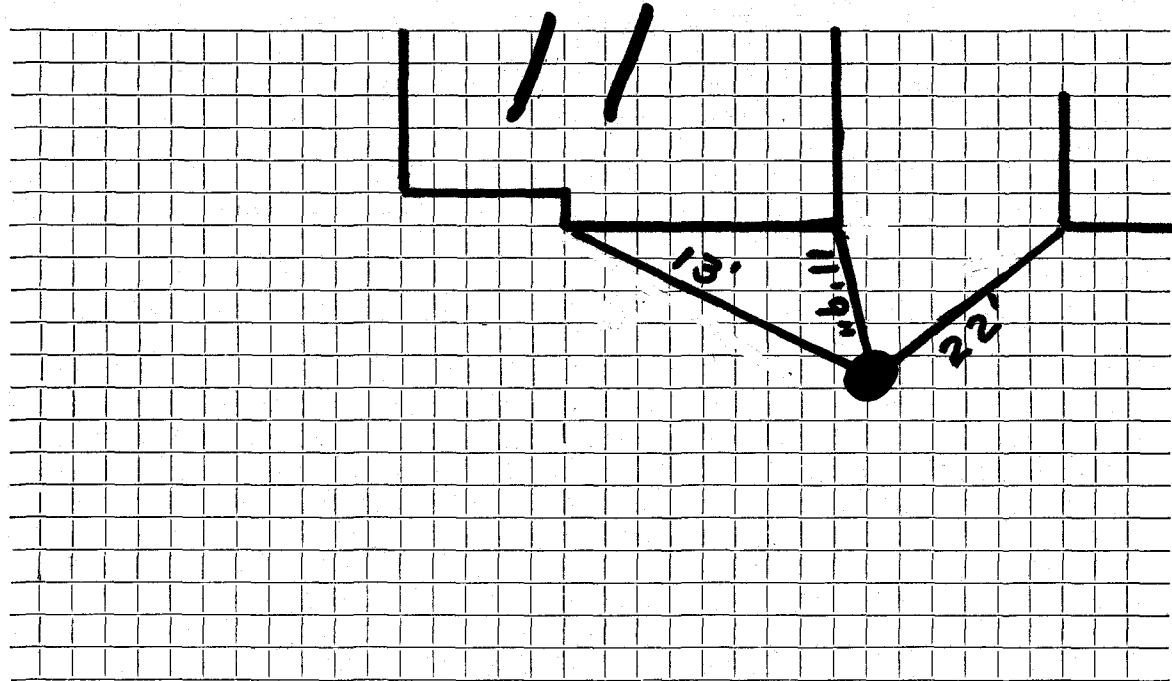

Connection made in Street. Work completed

Remarks:
.....
.....