

WATER SERVICE RECORD

Name Donald F. GreenService No. 46Address 13 Sylvia Street (vacant lot)# 418

Location

~~REPLACEMENT~~ - New Service W.O. #2714 Valeri #1749

DEC 31 1970


Date	Material	Amount	Total	Date	Amount
7-7-66	Labor	16 55		10-6-70	60 05
	10% O.H.	1 66	18 21		
14'	3/4" copper tubing @ .79		11 06		
1	3/4" Corp. Cock		7 42		
1	3/4" Curb. Cock		8 76		
1	Box & Rod		5 10		
1	Hr. Trucking		3 00		
1	Hr. Shovel		6 50		
			60 05		
	(TO BE BILLED WHEN CONNECTED)				
10/21/70	38' 3/4" Copper tubing				

DATE _____

TOWN OF LEXINGTON — BOARD OF PUBLIC WORKS

WATER DIVISION

Sketch of Service Here

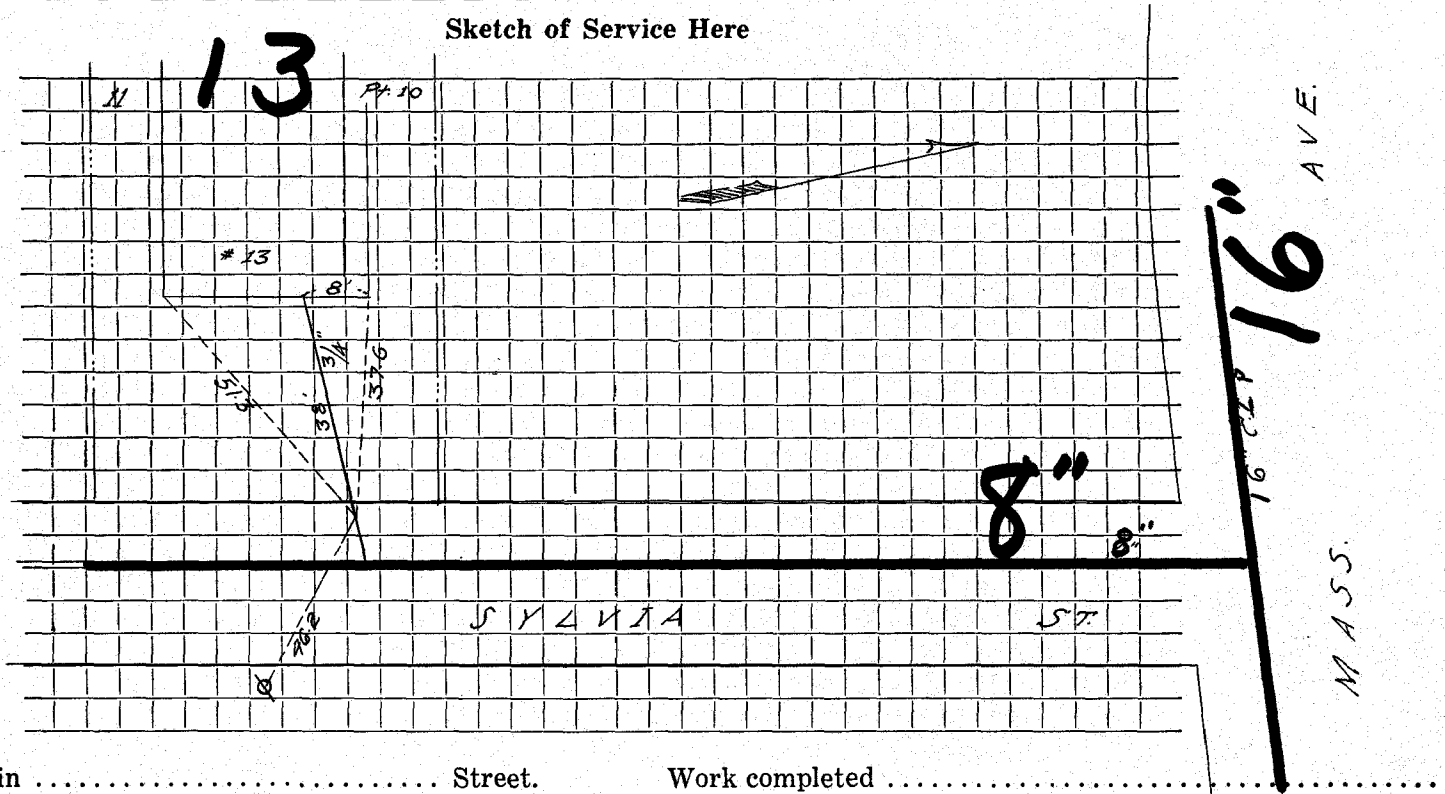

Connection made in Street. Work completed

Remarks:

.....

.....