

WATER SERVICE RECORD

Name Fred Terrazzano

Service No. 313

Address 16 Sylvia St., Lexington

Location

~~Renewal~~ - Renewal - ~~New Service~~

Com. 11-21-55


Date	Material	Amount	Total	Date	Amount
9/22/55	Labor	3 70		9-19-55 Deposited	30 00
	10% Overhead	37	4 07	8-14-57 Paid	5 74
	45'-3/4" Copper tubing @ .56		25 20	Non Charge	35 74
	1-3/4" Cx 1/2" I.W.H. stop & waste		4 00	9/22/55 Labor	87.98 39.15
	1-3/4" x 3/4" Union (3 part)		1 72	22'-3/4" Copper tubing @ .56	12 32
	1 hr. trucking @ .75		75	19 x 3 patch	19 00
			35 74	1 curb cock	4 67
				1 Box & Rod	3 90
				1-1/2" x 3/4" bushing	51
				2 hrs. Town Shovel @ 5.00	10 00
				1 hr. trucking @ .75	75
					173 28
				7/6/66 Bill sent 11-22-55	
				3' 3/4" C	
				3/4" COP.	
				.3/4" UNION	

TOWN OF LEXINGTON — BOARD OF PUBLIC WORKS

WATER DIVISION

Sketch of Service Here

16

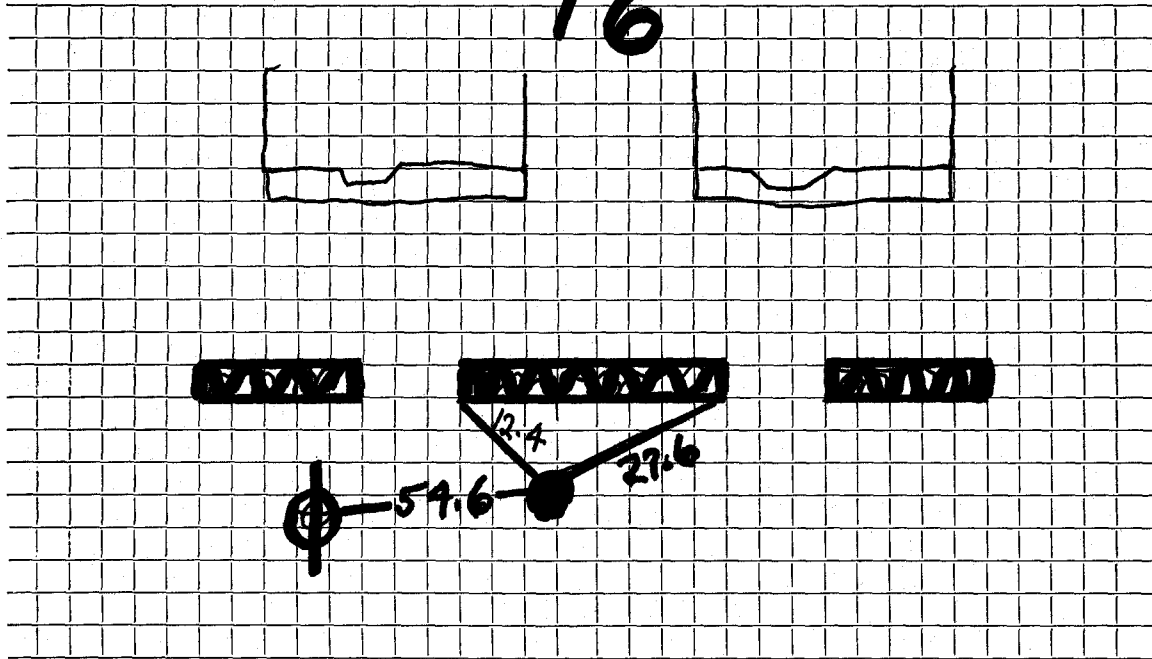

Connection made in ..... Street. Work completed .....

Remarks: .....

.....

.....