

WATER SERVICE RECORD

Name

Service No.

Address

19 Sylvia Street

Location

Repair—Renewal—New Service


Date	Material	Amount	Total	Date	Amount
9-20-'55'	32' 3/4" Copper				
	1 3/4" X 1/2" I.W.H.	STop + Waste		9-20-'55'	
				20' 3/4" Copper	
				1 3/4" Corp Cock	
				1 3/4" Curb Cock	
				1 Box Rod	
				7-6-'66' To New Main	
				4' 3/4" Copper	
				1 3/4" Corp Cock	
				1 3/4" UNION	

DATE _____

TOWN OF LEXINGTON — BOARD OF PUBLIC WORKS

WATER DIVISION

Sketch of Service Here

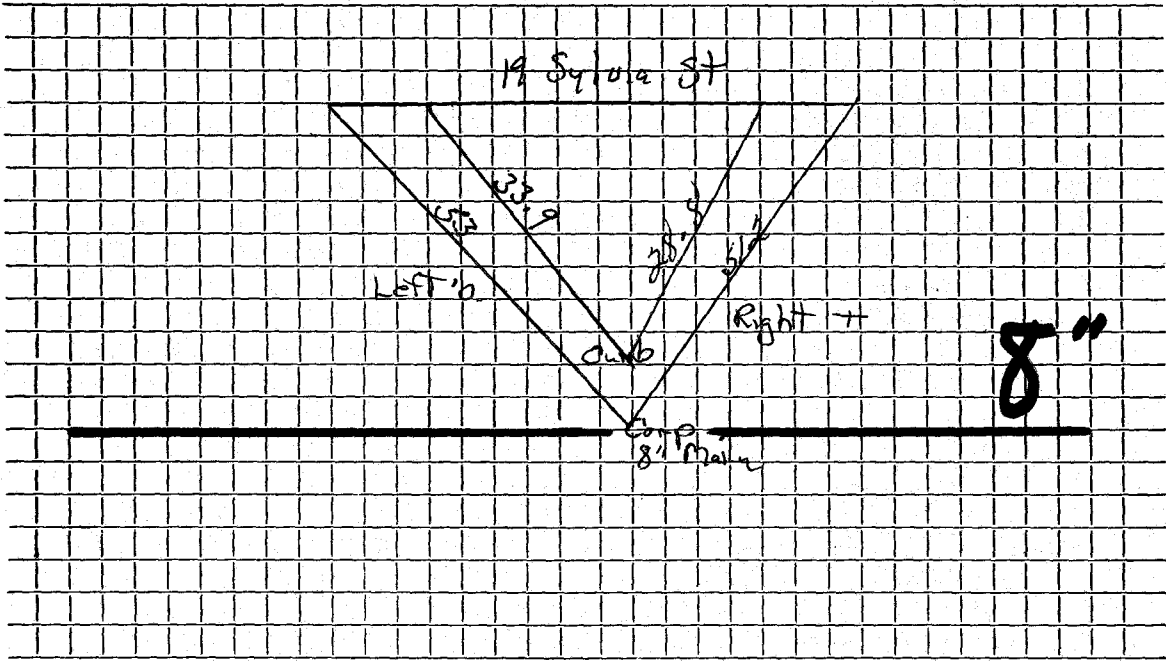

Connection made in Street. Work completed

Remarks:
.....
.....