

WATER SERVICE RECORD

Name C & G Const. Co.

Service No. 117

Address 22 Sylvia Street

Location Valeri Const. Co. - Permit #121

~~Repair~~ ~~Renewal~~ New Service W.O. #9290


DEC 28 1964

Date	Material	Amount	Total	Date	Amount
	Curb to Main				
10-28-64	Labor	4 36		10-2-64	50 00
	10% O.H.	44	4 80	12-28-64	11 53
	30' 3/4" Copper tubing @.42		12 60	11-1-'48'	38 47
	1 3/4" Corp Cock		7 41	33' 3/4" Copper	
	1 3/4" Curb Cock		8 76	1 3/4" C. Corp Cock	
	1 Box & Rod		4 90	1 3/4" C. X 3/4" C. Curb Cock	
			38 47	1 3/4" Repair Clamp	
10-30-64	35' 3/4" Copper tubing			7-5-'66	To New Main
				5' 3/4" Copper	
				1 3/4" C. Corp Cock	
				1 3/4" UNION	
				* Applied to SH #166	

TOWN OF LEXINGTON — BOARD OF PUBLIC WORKS

WATER DIVISION

Sketch of Service Here

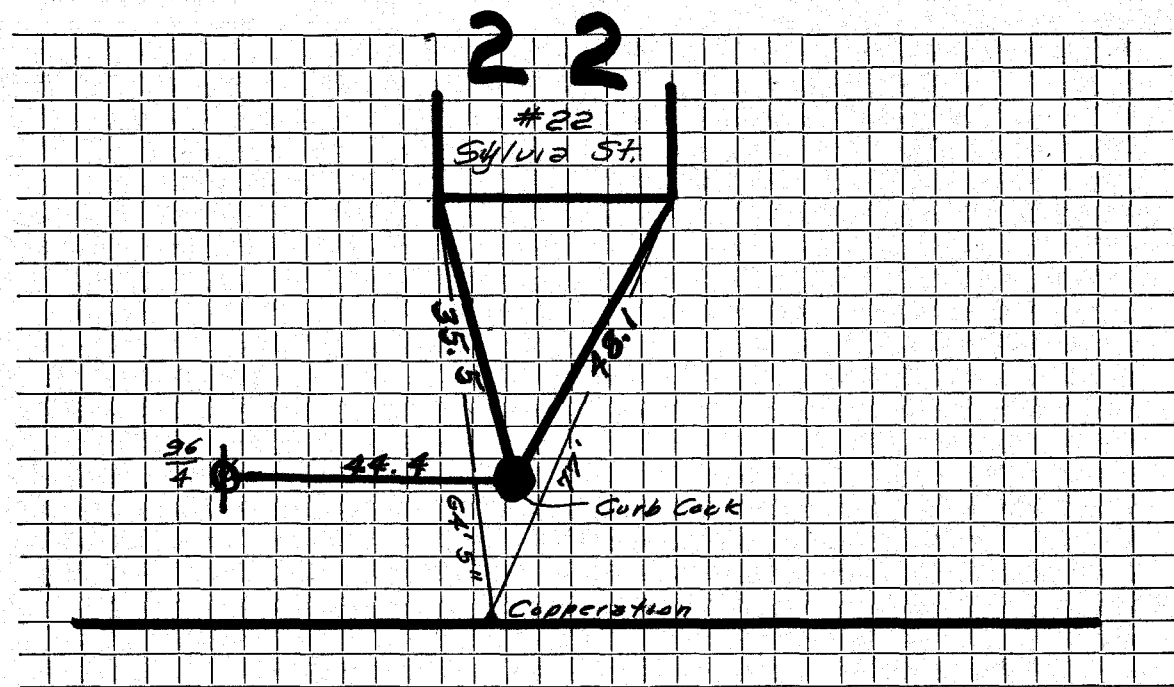

Connection made in Street. Work completed

Remarks:
.....
.....