

Name Hebrew Synagogue

Service No. ~~58~~ 2621

Address Sylvia Street

Location #23 Sylvia St

Kind of Pipe

Size

Size of Main

~~Repair - Renewal - New Service~~

Location

Date  
1941

Material

Amount

Total

Date

Amount

June 4

8 hrs. @ 55¢

4 40

May 19 1941

Deposited

30 00

*from 6/30/41*

22 " @ 60¢

13 20

July 2 1941

Refunded

2 49

2 " @ 70¢

1 40

19 00

27 57

10% Overhead

1 90

7-5-'66'

To New Main

19' 3/4" Copper tubing @ 19¢

3 61

3' 3/4" Copper

1 3/4" C. S. & W.

2 25

1 3/4" Corp. Cock

Trucking - 1 hr. @ 75¢

75

1 3/4" UNION

27 51

Labor

DATE \_\_\_\_\_

# TOWN OF LEXINGTON—BOARD OF PUBLIC WORKS

## WATER DIVISION

The undersigned applies for a supply of water at No. \_\_\_\_\_ St. and hereby agrees to comply with the rules and regulations as now, or at any future time, established by the Board of Selectmen.

Am't. of Estimate \$ \_\_\_\_\_


Owner \_\_\_\_\_

Am't. Paid \$ \_\_\_\_\_

Address \_\_\_\_\_

Builder \_\_\_\_\_

Sketch of Service Here

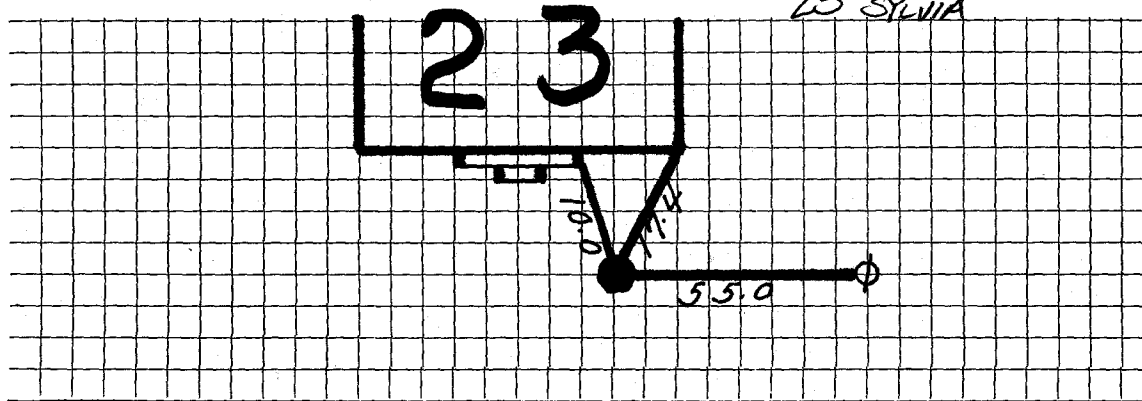

Connection made in \_\_\_\_\_ Street.

Work completed \_\_\_\_\_ 19

Remarks: