

WATER SERVICE RECORD

Name **G & C Construction Co.**

Service No. **136**

Address **26 Sylvia Street *Ld 69-20***

Location **Valeri Const. Co. Permit #155**

~~Repair~~ **New Service W.O. #9340**

FEB 15 1965


Date		Material	Amount	Total	Date	Amount
12-3-64		Labor	4.62		11-9-64	50.00
		10% O.H.	.46	5.08		
	27'	3/4" Copper tubing @.42		11.34		
	1	3/4" Corp Cock		7.41	7-5-'66	To New Main
	1	3/4" Curb Cock		8.76	4'	3/4" Copper
	1	Box & Rod		4.90	1	3/4" Corp Cock
	25	x 3 Patch		<u>25.00</u>	1	3/4" UNION
				62.49		

Bill 512T 1248

TOWN OF LEXINGTON — BOARD OF PUBLIC WORKS

WATER DIVISION

Sketch of Service Here

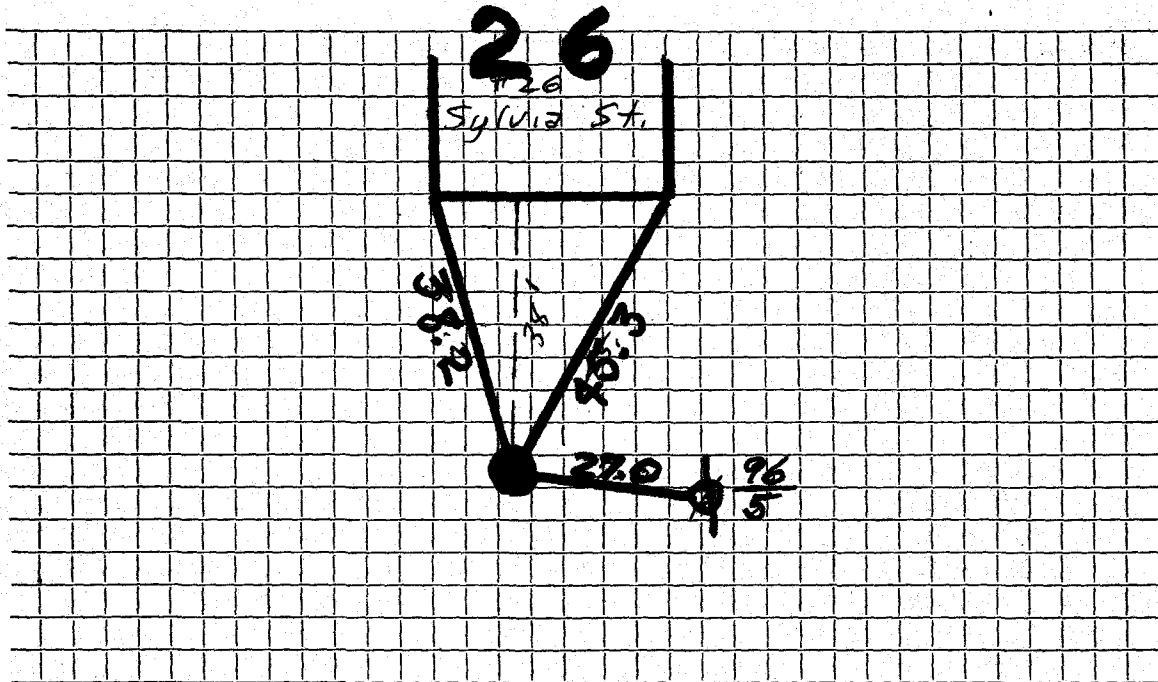

Connection made in Street. Work completed

Remarks:
.....
.....