

WATER SERVICE RECORD

Name Alex MacMillan

Service No. 94

Address 27 Sylvia Street

2160

Location

~~XXXXXX~~ New Service W.O. #7485


Comm 10-29-62

Date	Material	Amount	Total	Date	Amount	
8-15-62	Labor	2.13		7-23-62	Deposit	50.00
	10% O.H.	.21	2.34	10-29-62	Re-Sum.	28.05
32'	3/4" Copper tubing @42		13.44			21.95
1	3/4" CX $\frac{1}{2}$ I.W.H. Stop & Waste		6.17			
			21.95		NON CHARGE	
				8-15-62	Labor	2.13
				7'	3/4" Copper tubing @42	2.94
				1	3/4" C Corp Cock	4.91
				1	3/4" C Curb Cock	6.28
				1	Box & Rod	4.90
				1	$\frac{1}{2}$ Straight Tailpiece	.50
				1	$\frac{1}{2}$ Offset Tailpiece	.50
				7-7-'66	To New Main	22.26
				4'	$\frac{3}{8}$ " Copper	
				1	$\frac{3}{4}$ " Corp Cock	
				1	$\frac{3}{4}$ " Union	

DATE _____

TOWN OF LEXINGTON — BOARD OF PUBLIC WORKS
WATER DIVISION

Sketch of Service Here

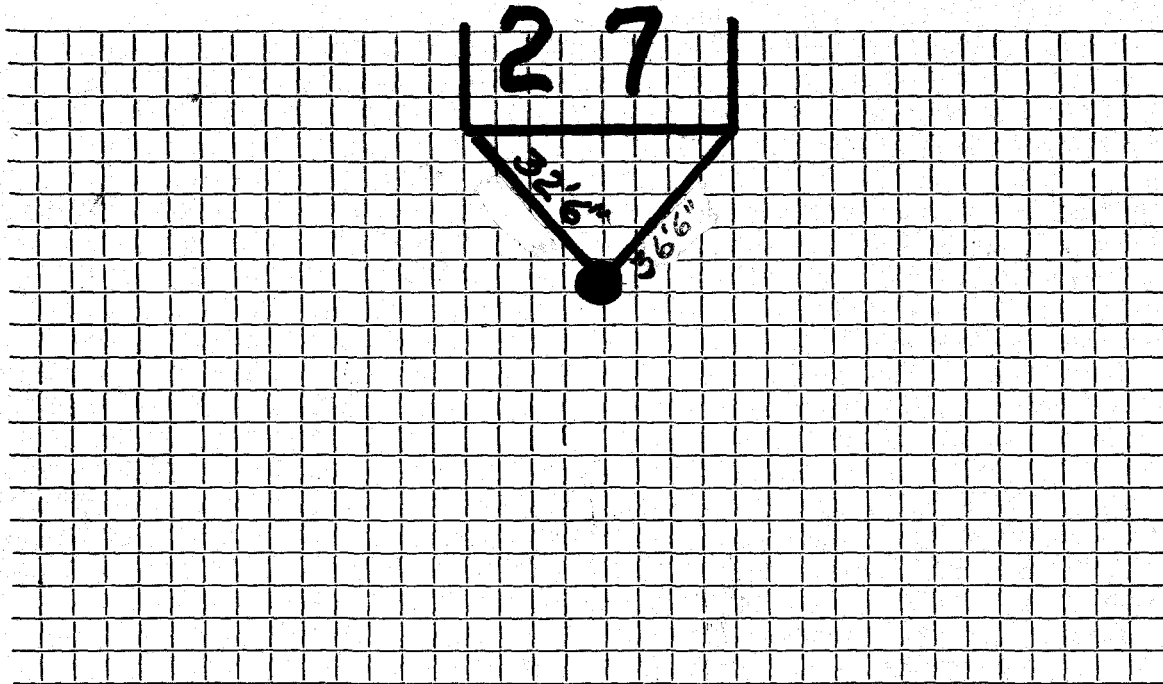

Connection made in Street. Work completed

Remarks:

.....

.....