

**WATER SERVICE RECORD**

Name **Nathan H. Butler**

Service No. **144**

Address **28 Sylvia Street**

Location

~~Repair - Renewal - New Service~~

Comm. 12-10-62


Date	Material	Amount	Total	Date	Amount
10-11-62	Labor	55.13		10-10-62	Deposit 100.00
	10% O.H.	5.13	60.26	12-16-62	Refund 2.39
29'	3/4" Copper tubing @.42		12.18		99.61
1	3/4" CX 1/2 I.W.H. Stop & Waste		6.17		
2	Hrs. Town Shovel @6.50		13.00		
2	Hrs. Trucking @3.00		6.00		NON CHARGE
			97.61	10-11-62	1/8 Straight Tailpiece .50
					1 1/8 Offset Tailpiece .50
				7-5-'66	1.00
					5' 3/4" Copper
					1 3/4" Corp Cock
					1 3/4" Union

DATE \_\_\_\_\_

# TOWN OF LEXINGTON — BOARD OF PUBLIC WORKS

## WATER DIVISION

Sketch of Service Here

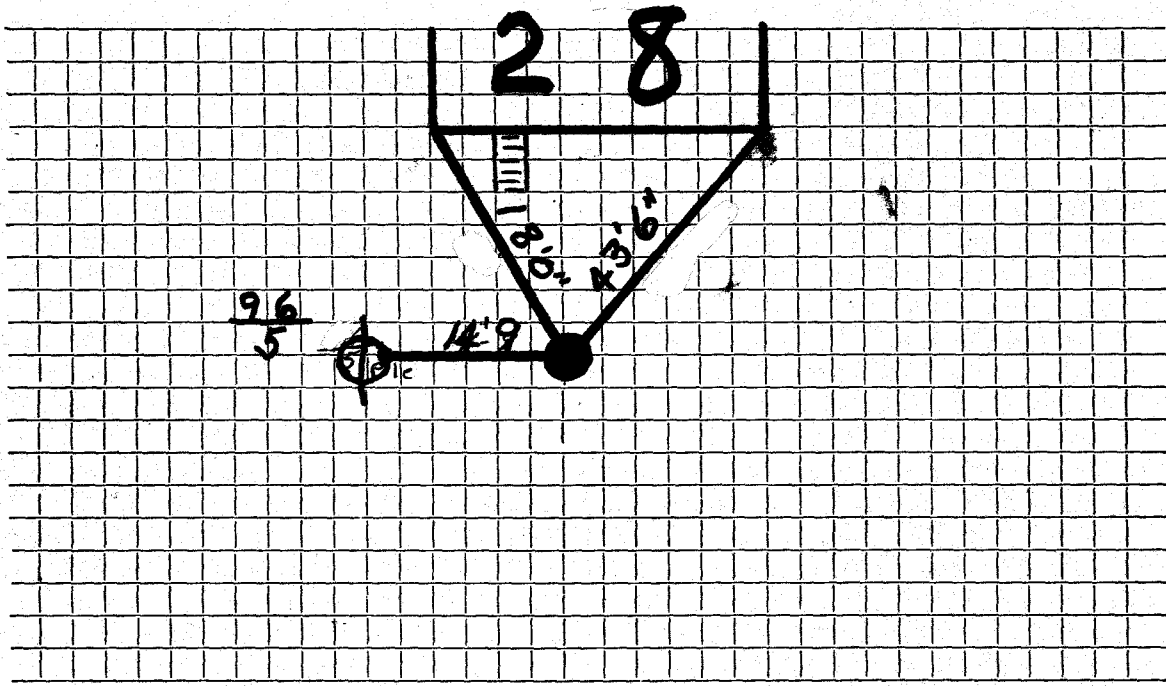

Connection made in ..... Street. Work completed .....

Remarks: installed in 1926 .....

Cost of service 79.52 .....