

Name William J. Roberts

Service No. ~~15~~ 2623

Address 31 Sylvia Street, Lexington, Mass.

Location

Kind of Pipe

Size

Size of Main

~~Repair—Renewal—New Service~~

Location

Date	Material	Amount	Total	Date	Amount
June 8, 1939	16 hrs. @ 50¢	8 00		June 5, 1939	35 00
<i>Sum 6-20-39</i>	5½ " 55¢	3 03			
	17 " 60¢	10 20			
	1 " 65¢	65	21 88		
	10% overhead		2 19	7-5-'66	To New Main
	15' ¾" Cop. Tubing @ 20¢		3 00	4' ¾" Copper	
	1 ¾" C x I S. & W.		3 75	1 ¾" Corp Cock	
	5½ hrs. Compressor @ 3.00		16 50	1 ¾" Union	
	2 hrs. Trucking @ .75		1 50		
	Trench Repairs		4 00		
			<u>\$52 82</u>		
	Charge \$35.00.				
	Labor				

DATE May 15, 1929

TOWN OF LEXINGTON—BOARD OF PUBLIC WORKS

WATER DIVISION


The undersigned applies for a supply of water at No. 31 Sylvia St St. and hereby agrees to comply with the rules and regulations as now, or at any future time, established by the Board of Selectmen.

Am't. of Estimate \$ 31-00 *Town digging, 1* Owner William J Roberts
shy actual cost,

Am't. Paid \$ _____ Address 31 Sylvia St
Lexington

Builder _____

Sketch of Service Here

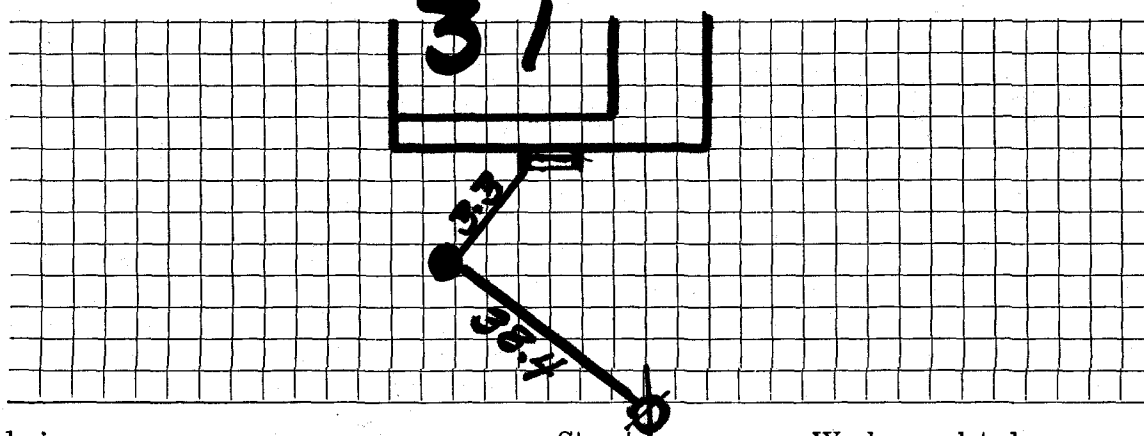

Connection made in _____ Street.

Work completed _____ 19

Remarks: