

WATER SERVICE RECORD

Name Frank O'Neal

Service No. 112

Address 33 Sylvania St.

Location Lexington

~~Renewal - NEW SERVICE~~


Cm. 7-13-53

Date	Material	Amount	Total	Date	Amount
5/27/53	Labor	1 75		5-25-53	Deposited 20 00
	10% overhead	18	1 93	7-13-53	Refunded (5 98)
	20'-3/4" Copper Tubing @.37	7 40	7 40		NON CHARGE 14 08
	1-3/4" C x 1/2 I.W.H. STOP & WASTE	4 00	4 00	5/27/53	Labor 26 75
	1 Hr. Trucking		75	8'-3/4" Copper Tubing @.37	2 96
			14 08	1-3/4" C. Corp-cock	4 33
	TRENCH DUG BY OWNER.			1-3/4" C. Corp-cock	4 67
				1-Box & Rod	3 90
				1-1/2 straight tail piece	50
				1-1/2 offset tail piece	50
				1 Hr. Littlefield Shovel	7 50
				1 Hr. Trucking	75
				Patching 4 x 3	4 00
				7-5-'66 To New Main	55 86
				8' 3/4" Copper	
				1 3/4" Corp Cock	
				1 3/4" UNION	

DATE _____

TOWN OF LEXINGTON — BOARD OF PUBLIC WORKS
WATER DIVISION

Sketch of Service Here

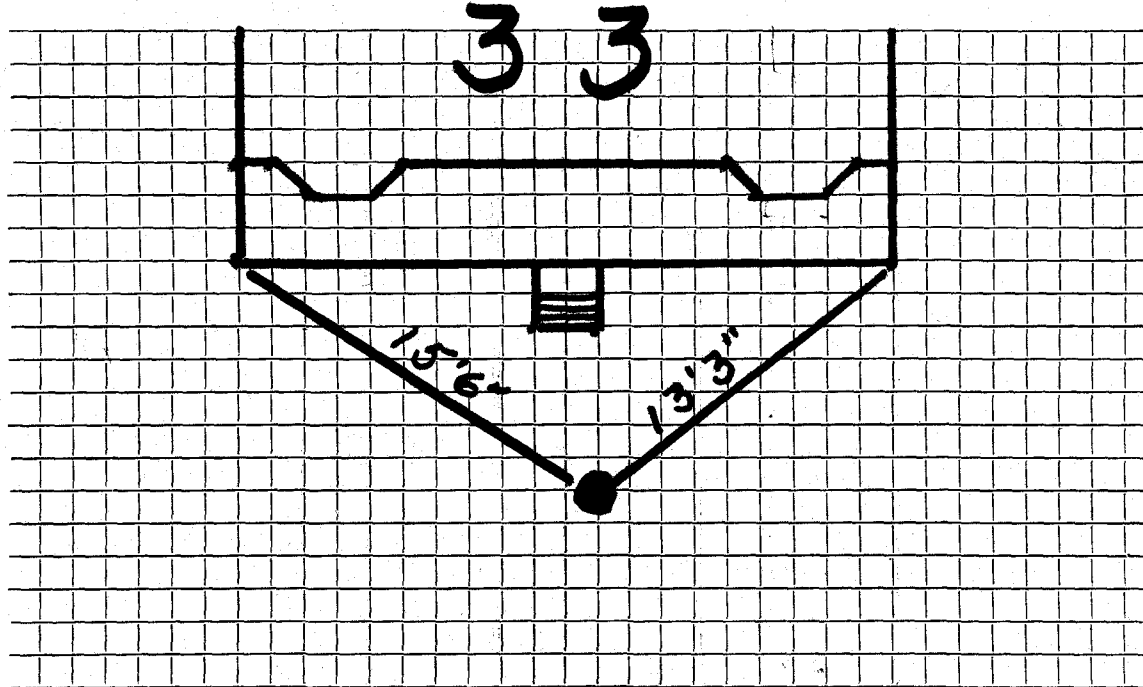

Connection made in Street. Work completed

Remarks:
.....
.....