

**WATER SERVICE RECORD**

Name

Service No.

Address

Location *4 Sylvia ST.*

Repair—Renewal—New Service


Date	Material	Amount	Total	Date	Material	Amount
8-1-'49'						
	33' 1" Copper					
	1 1" C. X 3/4" I.W.H. Stop + Waste			8-1-'49'		
					28' 1" Copper	
					1 1" C. Corp Cock	
					1 1" C. X 1" C. Curb Cock	
					1 Box + Rod	
				7-7-'66'	To New Main	
					3' 1" Copper	
					1 1" C. Corp Cock	
					1 1" Union	

DATE \_\_\_\_\_

TOWN OF LEXINGTON — BOARD OF PUBLIC WORKS

WATER DIVISION

Sketch of Service Here

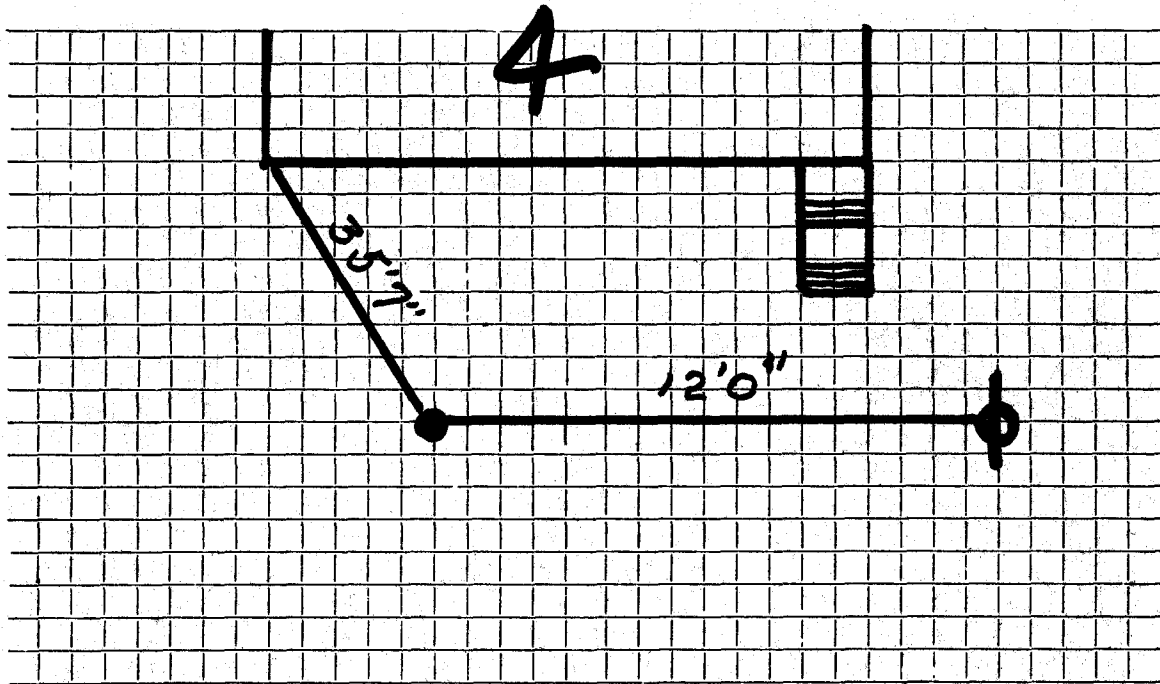

Connection made in ..... Street. Work completed .....

Remarks: .....  
.....  
.....