

## WATER SERVICE RECORD

Name John J. Quinn

Service No. 103

Address 5 Sylvia Street

Location

~~XXXXXX~~ Renewal ~~XXXXXX~~ W.O. #8210

Comm 10-28-63


Date	Material	Amount	Total	Date	Amount
10/1/63	Labor	70 23		9-23-63	Deposit 125 00
	10% O.H.	7 02	77 25	2-25-64	Paid 21 79
	63' 3/4" Copper Tubing @ .42		26 46		146 79
	1 3/4" Cx 1/2 I.W.H. Stop & Waste		6 17		
	1 3/4" C3 Part Unions		2 41	10/1/63	Labor 10 03
	4 Yards Loam @ 3.00		12 00		9' 3/4" Copper Tubing @ .42 3 78
	3 Hrs. Town Shovel @ 6.50		19 50		1 3/4" C Corp Cock 4 91
	1 Hr. Trucking @ 3.00		3 00		1 3/4" C Curb Cock 6 28
			146 79		1 Bow & Rod 4 90
					1 1/2 Straight Tailpiece 50
					1 1/2 Offset Tailpiece 50
					12 X 3 Patch 12 00
				7-7-66	42 90
					5' 3/4" Copper
					1 3/4" Corp Cock
					1 3/4" Union
					Bill sent 2179

DATE \_\_\_\_\_

TOWN OF LEXINGTON — BOARD OF PUBLIC WORKS

WATER DIVISION

Sketch of Service Here

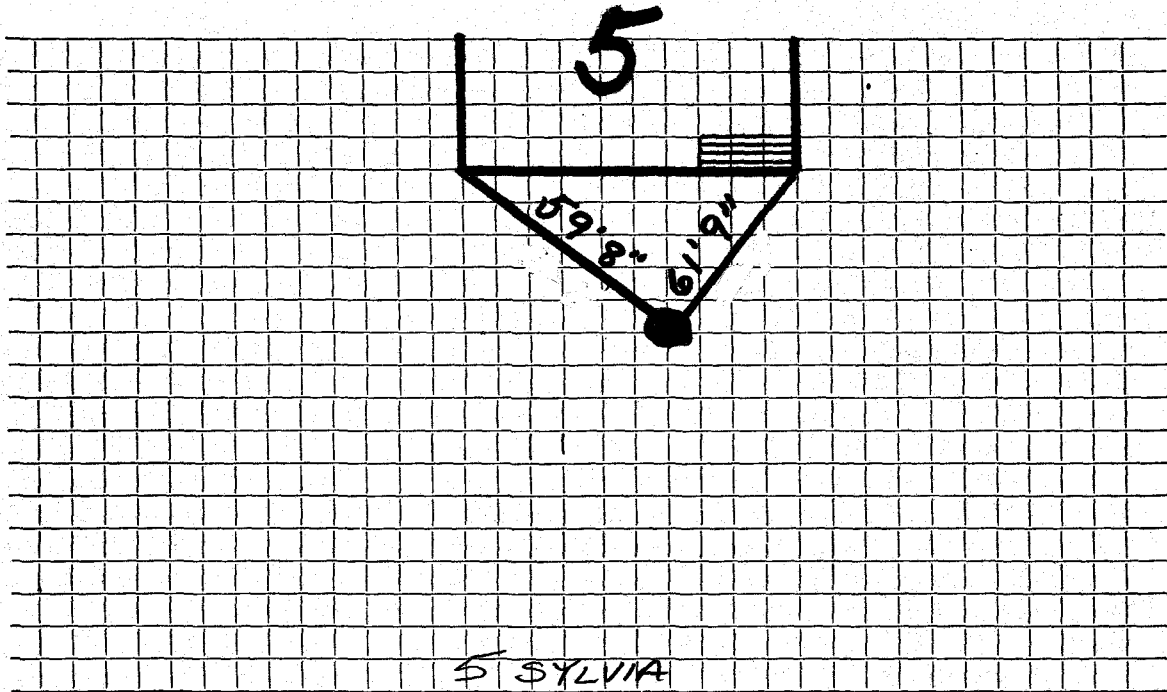

5 SYLVIA

Connection made in ..... Street. Work completed .....

Remarks: .. Service .. first .. installed .. 1927 .....

.....  
.....