

Name Thomas Sullivan

Service No. ~~15~~ 2612

Address 17 Curve St., Lexington

6831

Location 7-9 Sylvia Street.

Kind of Pipe

Size

Size of Main

~~Repair~~ - Renewal - ~~New Service~~

Location

Date  
1943

Material

Amount

Total

Date

Amount

July 12, 1943  
Com 7/12/43

9 hrs. @ 70¢  
1 " @ 80¢  
10% Overhead  
12' 3/4" Copper tubing @ 21¢  
1 3/4" C.x 1/2" I.W.H.S. & W.  
1 hr. trucking

6 30  
80

7 10  
71  
2 52  
2 36  
75  
13 43

June 11, 1943 Deposited  
Sept 10, 1943 Paid

12 00  
1 43  
13 43

Non-chargeable:

Labor

8' 3/4" Copper tubing @ 21¢  
1 3/4" " curb cock  
1 3/4" " union  
1 1/2" str. tail pc.  
2 hrs. compressor @ 1.75  
1 " trucking  
Labor  
French repairs

14 80  
1 68  
2 75  
88  
88  
3 50  
75  
5 34  
30 08

Bel for 1.43 sent 7/27/43

Hidley Press, Inc., Lexington

DATE June 21, 1943

# TOWN OF LEXINGTON—BOARD OF PUBLIC WORKS

## WATER DIVISION

The undersigned applies for a supply of water at No. 749 Reyleia St. and hereby agrees to comply with the rules and regulations as now, or at any future time, established by the Board of Selectmen.


Am't. of Estimate \$ 12.00

Owner Thomas Sullivan

Am't. Paid \$ \_\_\_\_\_

Address 17 Currier St

Builder \_\_\_\_\_

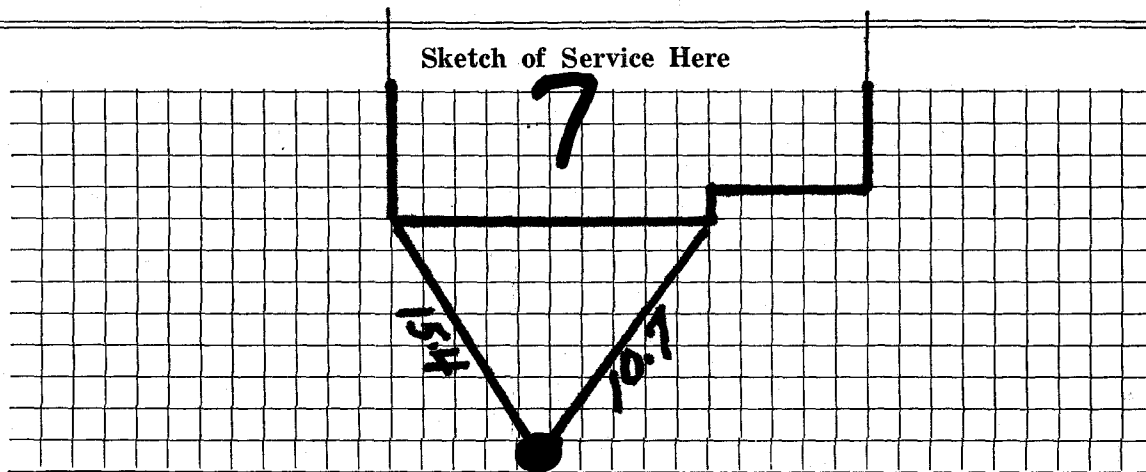

Connection made in \_\_\_\_\_ Street.

Work completed \_\_\_\_\_ 19

Remarks: