

WATER SERVICE RECORD

Name

Service No.

Address 9 Sylvania Street

Location


~~REPAIR~~ - Renewal - ~~NEW SERVICE~~ curb to main

Date	Material	Amount	Total	Date	Amount
					NON CHARGE
				9-18-63	Labor 8.31
				9-19-63	" 84.06 92.37
					27' 3/4" Copper tubing @.42 11.82
					1 3/4" C Corp Cock 4.91
					1 3/4" C Curb Cock 6.28
					1 Box & Rod 4.90
					3 hrs. Town Shovel @6.50 19.50
					2 hrs. Trucking @3.00 6.00
				7-7-66	To New Main 145.78
					6' 3/4" Copper
					1 3/4" C. Corp Cock
					1 3/4" UNION

TOWN OF LEXINGTON — BOARD OF PUBLIC WORKS

WATER DIVISION

Sketch of Service Here

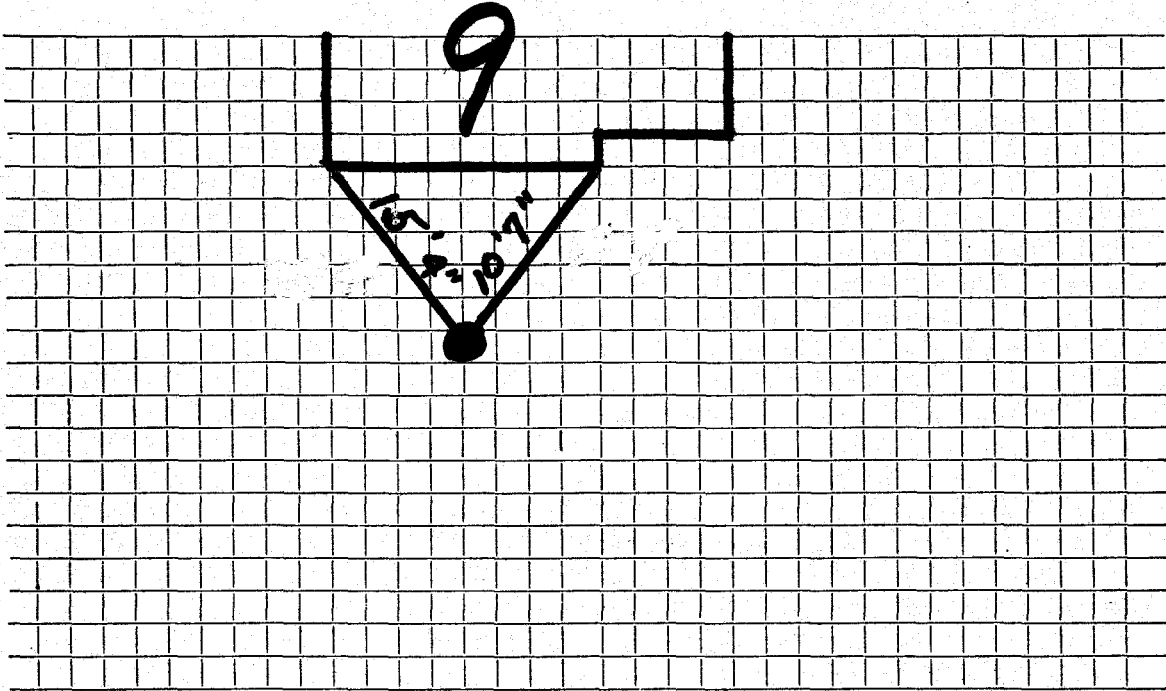

Connection made in Street. Work completed

Remarks:
.....
.....