

Name Harry E. Johnson

Service No. 352630

Address 1070 Mass. Ave., Arlington

#10 Taft Ave.

# 793

Location Lot #5 Taft Ave.

Kind of Pipe

Size

Size of Main

~~Repair-Work~~ - New Service

Location

Date	Material	Amount	Total	Date	Amount
Sept. '34	37' 3/4" C. Pipe @.16	\$5 92			
Com. 11-70 to Russell 12-31-34	1 S & W Trucking	2 75 75	9 42	Aug. 25-1934 - ply jointed	11 70
	3 Hrs. Labor @.55	1 65		Checked outside 3/4 Copper	
	2 " " @.60	1 20	2 85		
	<u>GOST</u>		12 30		
<u>CHARGE</u>	39' @ .30	\$11 70	\$11 70		
	Labor				

Hadley Pressing Co., Lexington

# TOWN OF LEXINGTON—BOARD OF PUBLIC WORKS

## WATER DIVISION

The undersigned applies for a supply of water at No. \_\_\_\_\_ St. and hereby agrees to comply with the rules and regulations as now, or at any future time, established by the Board of Selectmen.


Am't. of Estimate \$ \_\_\_\_\_

Owner \_\_\_\_\_

Am't. Paid \$ \_\_\_\_\_

Address \_\_\_\_\_

Builder \_\_\_\_\_

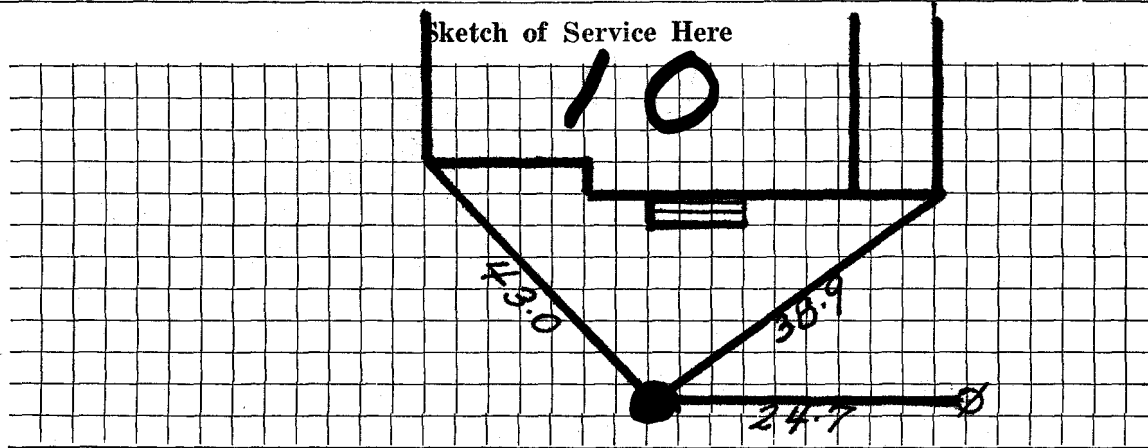

Connection made in \_\_\_\_\_ Street.

Work completed \_\_\_\_\_ 19

Remarks: