

Name Harry E. Johnson

Service No. 50 2631

Address Mass. Avenue, Arlington

#11 Taft Ave.

Location Lot #39 Taft Avenue

Kind of Pipe

Size

Size of Main

~~Repair - Renewal~~ - New Service

Location

Date

Material

Amount

Total

Date

Amount

33	1" C.L. Pipe @ 27¢	8 91
1	1" L.L. Ell @	45
1	1" L.L. Coup. @	75
1	Stop & Waste	2 00
	Trucking	1 00

\$13 11

Bill mailed 11-21-35

3-5-98

Outside Checked
3/4 Copper

June 26 - 1936 Deposited

5 35
<u>7 76</u>
13 11

Labor

Hadley Press, Inc., Lexington

Comm. to Russell
10-22-35 \$13.11

DATE _____

TOWN OF LEXINGTON—BOARD OF PUBLIC WORKS

WATER DIVISION

The undersigned applies for a supply of water at No. _____ St. and hereby agrees to comply with the rules and regulations as now, or at any future time, established by the Board of Selectmen.


Am't. of Estimate \$ _____

Owner _____

Am't. Paid \$ _____

Address _____

Builder _____

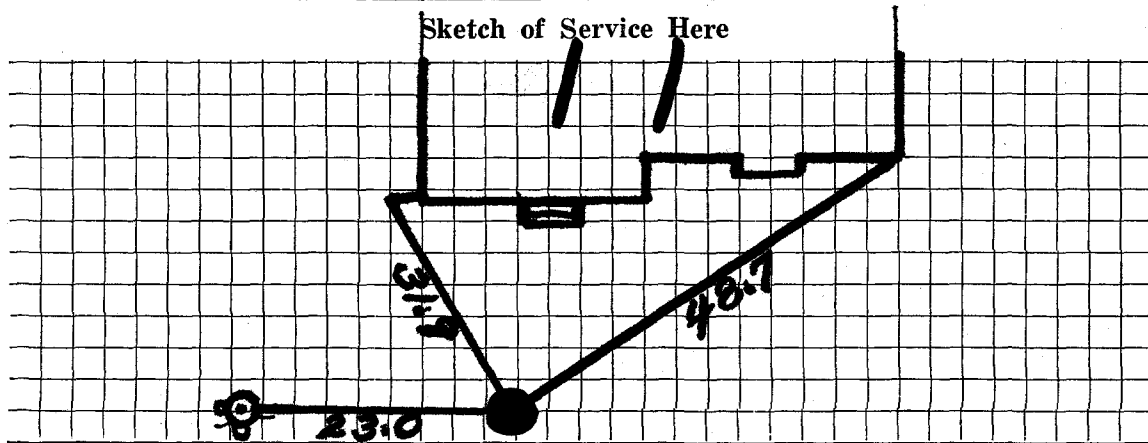

Connection made in _____ Street.

Work completed _____ 19

Remarks: