




DATE 8-16-01

TOWN OF LEXINGTON — BOARD OF PUBLIC WORKS

WATER DIVISION

Sketch of Service Here

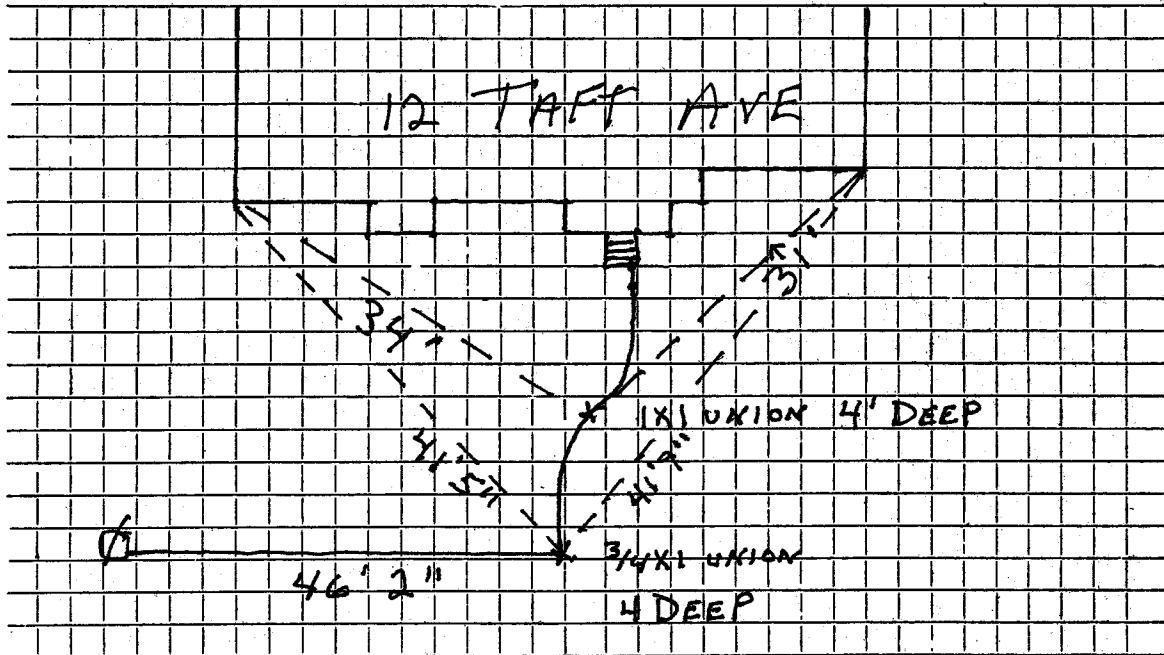

Connection made in ..... TAFT AVE ..... Street.

Work completed ..... 5-30-01 .....

Remarks: .....  
.....  
.....