




DATE \_\_\_\_\_

TOWN OF LEXINGTON — BOARD OF PUBLIC WORKS

**WATER DIVISION**

Sketch of Service Here

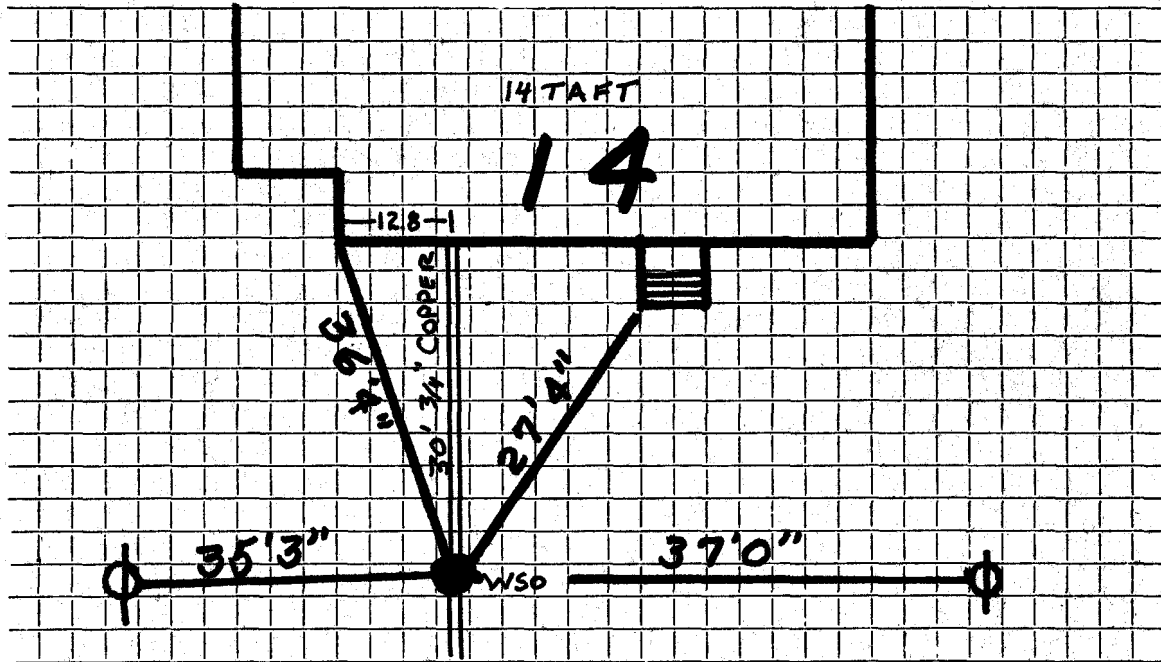

Connection made in TAFT AVE Street. Work completed .....

Remarks: 6" PVC SEWER 2' DIRECTLY BELOW WATER - Original Service 10-5-1935