

Name Harry Johnson

Service No. ~~25~~ 2634

Address Massachusetts Avenue, Arlington #15 Taft Ave. # 1978

Location Taft Avenue (Lot 36)

Kind of Pipe Size Size of Main

~~Repair - Renewal~~ - New Service Location

Date	Material	Amount	Total	Date	Amount
July '35 36'	1" C.L. Pipe @ 27¢	9 72		July 3 1935	13 95
	1" L.L. Coupling	75			
	1" L.L. Ell	45			
	1 Stop & Waste	2 00			
	Trucking	<u>1 00</u>			
			\$13 92		
	Say \$13.95				checked outside 3/4 Copper
	Labor				

Hadley Press, Inc., Lexington

Com. to Russell
#13.95 - 10-22-35

Deposited
Cash

DATE July 3, 1935.

TOWN OF LEXINGTON—BOARD OF PUBLIC WORKS

WATER DIVISION

31
245
230
15

The undersigned applies for a supply of water at No. 245 36 Taft Avenue St. and hereby agrees to comply with the rules and regulations as now, or at any future time, established by the Board of Selectmen.

Am't. of Estimate \$ 13.95


Owner Harry L. Johnson

Am't. Paid \$ _____

Address _____

Builder _____

Sketch of Service Here

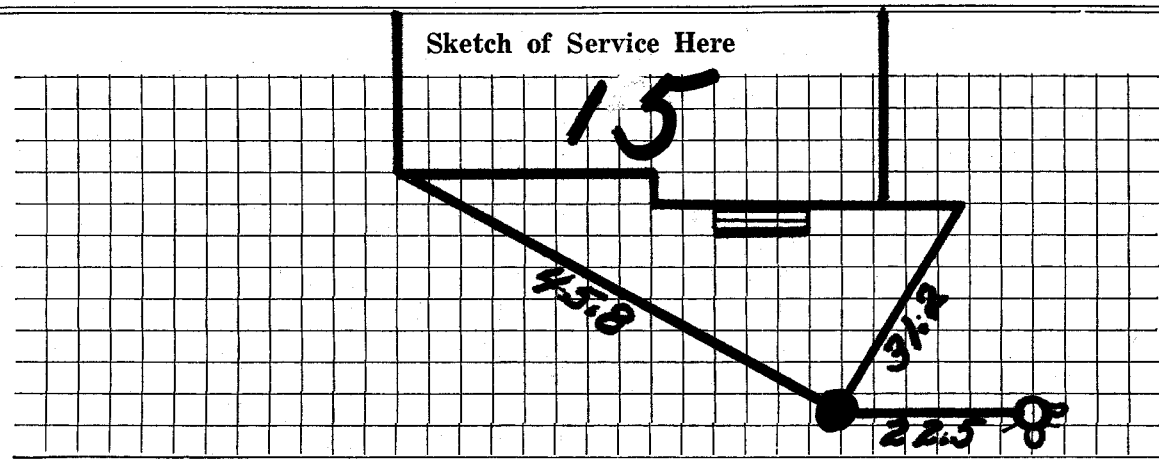

Connection made in _____ Street. Work completed _____ 19

Remarks: