

Name Harry E. Johnson

Service No. # 2636

Address 50 Brighton Street., Belmont

2059

18 Taft Ave.

Location

*#18 Taft Ave.
Lot #9 Taft Ave.,*

Kind of Pipe

Size

Size of Main

~~Repair~~ ~~Renewal~~ - New Service

Location

Date 1936	Material	Amount	Total	Date	Location	Amount
Nov. 25	3 hrs @ .60	1 80				
<i>Com 2-16-37</i>	Overhead	18	1 98	<i>Oct. 30 1936</i>	<i>Deposited</i>	20 00
	48' 1" C.L. Pipe @ 27¢-12	90		<i>Feb. 25 1937</i>		3 05
	4 1" L/L/Coup. @ 18¢	72				95
	2 1" L/L/Ells @ 25¢	50				24 00
	2 1" S. Nipples @ 35¢	70				
	1 S. & W.	1 75	16 57		<i>Checked Outside 3/4 Copper</i>	
			18 55			
	Say: 48" @ .50		24 00			
	Labor					

Hadley Press, Inc., Lexington

DATE October 28, 1936

TOWN OF LEXINGTON—BOARD OF PUBLIC WORKS

WATER DIVISION

The undersigned applies for a supply of water at No. 20 ^{Lot #} Tapscott St. and hereby agrees to comply with the rules and regulations as now, or at any future time, established by the Board of Selectmen.

Am't. of Estimate \$ 20.00

Owner


Henry J. Jones

Am't. Paid \$ _____

Address

50 Brighton St
Belmont

Builder _____

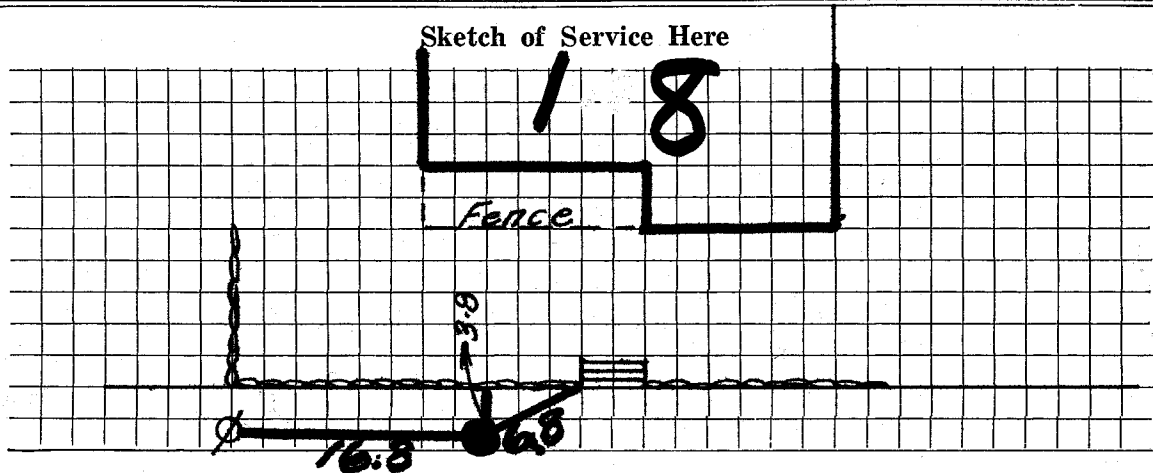

Connection made in _____ Street.

Work completed _____ 19

Remarks: