

Name Harry E. Johnson

Service No. 48 2637

Address 50 Brighton Street, Belmont.

19 Taft Ave.

Location

#19 Taft Ave.
Lot #32 Taft Ave.,

Kind of Pipe

Size

Size of Main

Repair—Renewal—New Service

37' @ 50¢

18.50 Flat Rates.

Location

Date

Material

Amount

Total

Date

Amount

June 21

2 hrs. @ .60

1 20

June 21, 1937 Deposited

18 50

Overhead

12

37' 3/4" Copper Tubing

@ .25

9 25

1 3/4" Stop and Waste

@ 3.75

3 75

2 hrs. Trucking

@ .75

1 50

15 82

Flat rates 37' @ .50

18 50

Checked outside
3/4 Copper

Labor

DATE _____

TOWN OF LEXINGTON—BOARD OF PUBLIC WORKS

WATER DIVISION

The undersigned applies for a supply of water at No. _____ St. and hereby agrees to comply with the rules and regulations as now, or at any future time, established by the Board of Selectmen.


Am't. of Estimate \$ _____

Owner _____

Am't. Paid \$ _____

Address _____

Builder _____

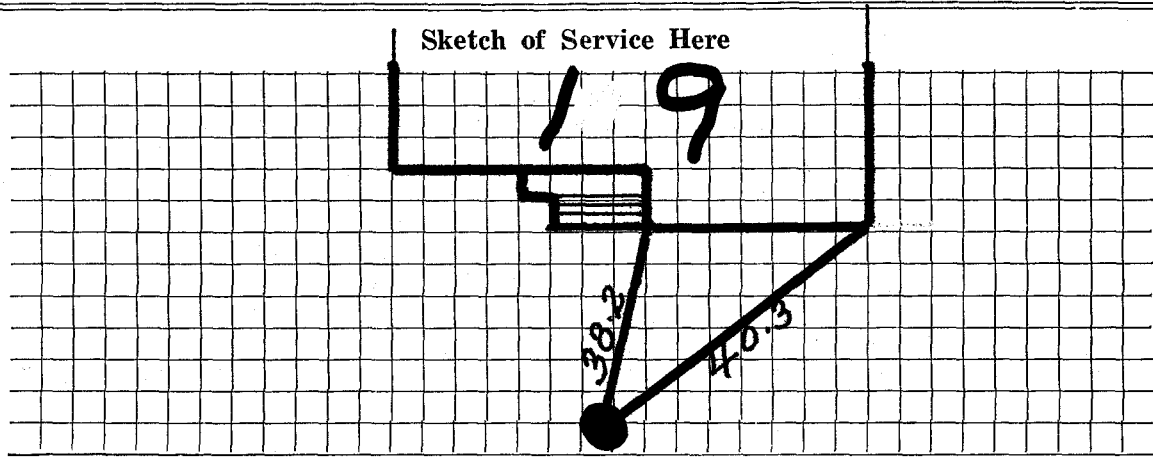

Connection made in _____ Street.

Work completed _____ 19

Remarks: