

Name Harry E. Johnson

Service No. ~~58~~ 2638

Address 211 Broadway, Arlington

#20 Taft

#5281

*20 1/2 H. Ave*

Location Lot #10 Taft Avenue

Kind of Pipe

Size

Size of Main

~~Repair - Renewal~~ - New Service

Location

Date

Material

Amount

Total

Date

Amount

1936

June 22

*Com. 7/1/36  
to Russell  
422.50*

4 hrs. labor @ 60¢

2 40

2 " " @ 55¢

1 10

3 50

10% Ovhd. on labor

35

45' 3/4" C. Tub. @ 19¢

8 55

1 Stop & Waste

1 75

Trucking

1 50

11 80

15 65

Chge. 45' @ 50¢

22 50

Labor

*Aug 21 1936 Deposited*

*22 50*

*Checked Outside  
3/4 Copper*

DATE \_\_\_\_\_

# TOWN OF LEXINGTON—BOARD OF PUBLIC WORKS

## WATER DIVISION

The undersigned applies for a supply of water at No. Lot # 10 Left Ave. St. and hereby agrees to comply with the rules and regulations as now, or at any future time, established by the Board of Selectmen.

Am't. of Estimate \$ \_\_\_\_\_

Owner

*Henry F. Johnson*


Am't. Paid \$ \_\_\_\_\_

Address

\_\_\_\_\_

Builder \_\_\_\_\_

Sketch of Service Here

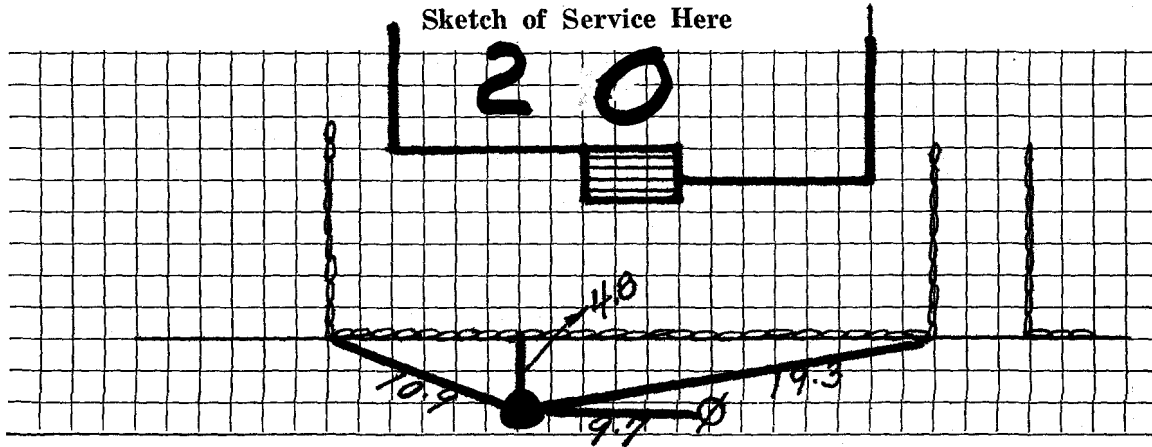

Connection made in \_\_\_\_\_

Street.

Work completed \_\_\_\_\_

19

Remarks: