

Name Harry E. Johnson

Service No. ~~34~~ 2641

Address -50 Brighton Street, Belmont

#24 Taft Ave

#879

24 Taft Ave

Location Lot 28- 24 Taft. Ave.,

Kind of Pipe

Size

Size of Main

Repair—Renewal—New Service

64' @ .50 32.00

Location

Date	Material	Amount	Total	Date	Amount
June 21	2 hrs. @ .60		1 20	June 4, 1937 Deported	32 00
<i>from 7/20/37</i>	Overhead		12		
	64' $\frac{3}{4}$ " Copper Tubing	@ .25	16 00		
	1 $\frac{3}{4}$ " Stop and Waste	3.75	3 75		
	1 $\frac{3}{4}$ " Copper Union		1 00		
	2 hrs. Trucking	@ .75	1 50		
			<u>23 57</u>		
	Flat Rate 64' @ .50		<u>32 00</u>		
	Labor				

Hadley Press, Inc., Lexington

DATE Dec 17 36

TOWN OF LEXINGTON—BOARD OF PUBLIC WORKS

WATER DIVISION

24 Taft.

The undersigned applies for a supply of water at No. 28 Taft Ave. St. and hereby agrees to comply with the rules and regulations as now, or at any future time, established by the Board of Selectmen.

Am't. of Estimate \$ _____

Owner

Harry E Johnson

Am't. Paid \$ _____


Address

50 Brighton St

Builder Harry E Johnson

Bulman
by Eric A. Sahlberg

Sketch of Service Here

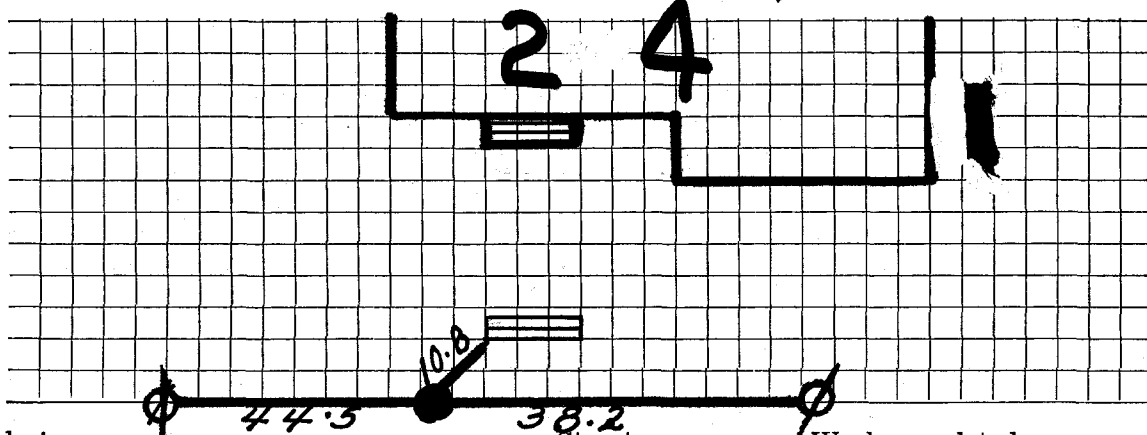

Connection made in _____ Street.

Work completed _____ 19

Remarks: