

Name Harry E. Johnson

Service No. ~~48~~ 2642

Address 50 Brighton St., Belmont.

6374

25 Taft Ave

25 Taft Ave

Location Lot #30 Taft Ave.,

Kind of Pipe

Size

Size of Main

Repair—Renewal—New Service

35' @ .50

17.50 Flat Rate

Location

Date

Material

Amount

Total

Date

Amount

June 21

2 hrs. @ .60

1 20

June 24 1937 Deposited

17 50

Overhead

12

35' L" C. L. Pipe @ .30

10 50

1 1" Stop and Waste

3.75

3 75

2 hrs. Trucking

.75

1 50

17 07

Flat Rates 35' @ .50

17 50

*Checked Outside
3/4 Copper*

Labor

Hadley Press, Inc., Lexington

DATE Dec 17-36

TOWN OF LEXINGTON—BOARD OF PUBLIC WORKS

WATER DIVISION

The undersigned applies for a supply of water at No. Lat 30 Twp Ave St. and hereby agrees to comply with the rules and regulations as now, or at any future time, established by the Board of Selectmen.

Am't. of Estimate \$ _____

Owner Harry E Johnson


Am't. Paid \$ _____

Address 50 Brightwood

Builder Harry E Johnson

Belmont
by Eric S. Selding

Sketch of Service Here

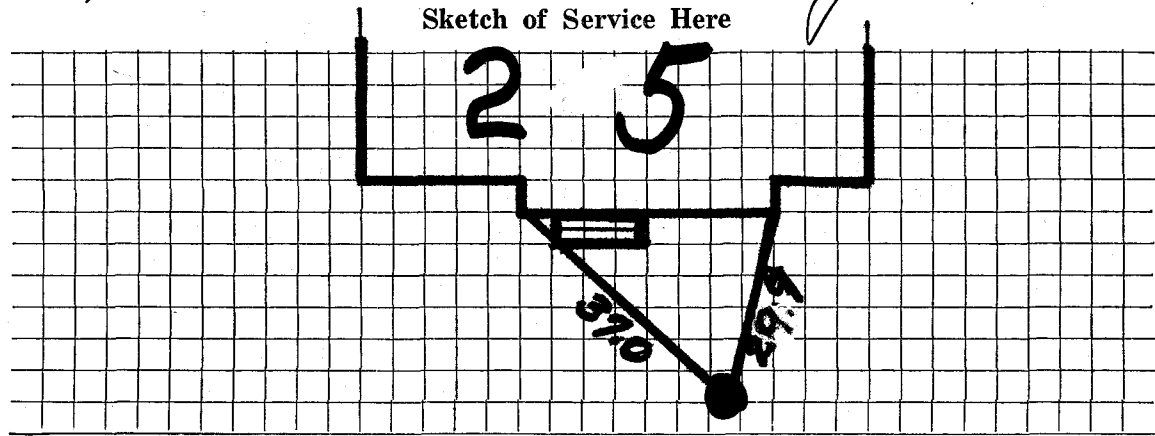

Connection made in _____ Street.

Work completed _____ 19

Remarks: