

Name **Harry E. Johnson**

Service No. **35 2643**

Address **50 Brighton St., Belmont**

26 TAFT

Location **Lot 29 (St.# 26) Taft.**

Kind of Pipe

Size

Size of Main

Repair—Renewal—New Service

40' @ .50

20' @

Location

Date	Material	Amount	Total	Date	Amount
June 21	2 hrs. @ .60		1 20	<i>June 4, 1937 Deposited</i>	<i>20 00</i>
	Overhead		12		
	40' 3/4" Copper Tubing	@ .25	12 00		
	1 3/4" C x 3/4" I. W. H. Stop and Waste	@ 3.75	3 75		
	2 hrs. Trucking	@ .75	1 50		
			<u>18 57</u>		
	Flat rate 40' @ .50		<u>20 00</u>		
	Labor				

Hadley Press, Inc., Lexington

DATE Dec 17-36

TOWN OF LEXINGTON—BOARD OF PUBLIC WORKS

WATER DIVISION

#26

The undersigned applies for a supply of water at No. Lot 29 Tenth Ave St. and hereby agrees to comply with the rules and regulations as now, or at any future time, established by the Board of Selectmen.

Am't. of Estimate \$ _____

Owner

Mary E Johnson

Am't. Paid \$ _____


Address

50 Brighton St

Builder Mary E Johnson

Belmont
by Eric S. Schuyler

Sketch of Service Here

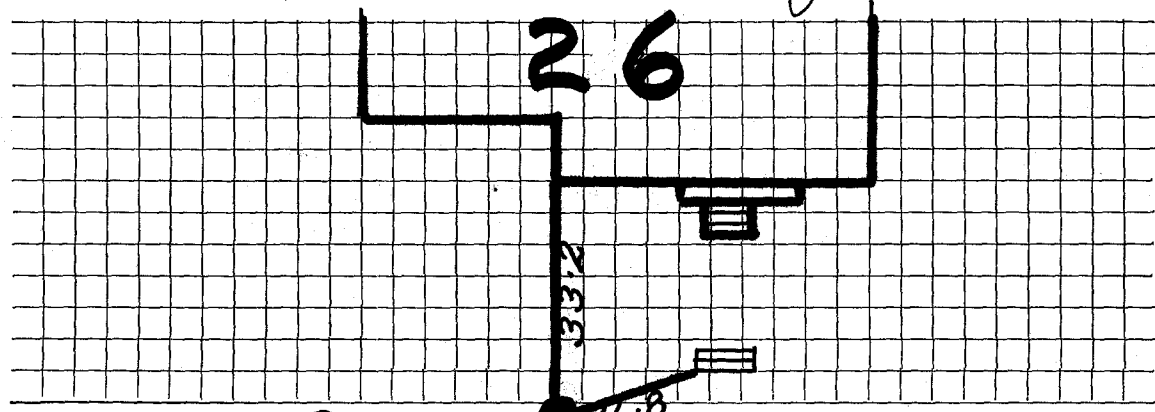

Connection made in _____

21.2 Street.

Work completed _____

19

Remarks: