

Name Lexington Homes, Inc.

Service No. ~~122~~ 2644

Address Lexington, Mass.

27 Taft Ave

Location 27 Taft Avenue

1842

Kind of Pipe

Size

Size of Main

Repair—Renewal—New Service

Location

Date
1941

Material

Amount

Total

Date

Amount

Nov. 8,

2 hrs. @ 60¢

1 20

October 29, 1941

Deposited

24 00

10% Overhead

12

Dec 30 1941

Refund

4 37

74' 3/4" Copper tubing @ 19¢

14 06

1 3/4" C.x 1/2" I.S. & W.

2 50

1 3/4" C. Union (3 part)

1 00

1 hr. trucking

75

19 63

19 63

8/7/63

*1" copper
Buff box*

*Refund deposited to
over service # W*

Labor

Hadley Press, Inc., Lexington

DATE Oct 17, 1941

TOWN OF LEXINGTON—BOARD OF PUBLIC WORKS

WATER DIVISION

The undersigned applies for a supply of water at No. 27 ^{Lot 20} Taft Ave. St. and hereby agrees to comply with the rules and regulations as now, or at any future time, established by the Board of Selectmen.

Am't. of Estimate \$ 24-

Owner Lexington Homes, Inc.


Am't. Paid \$ _____

Address 57 Bedford Street

Builder _____

Lex., Mass.

Sketch of Service Here

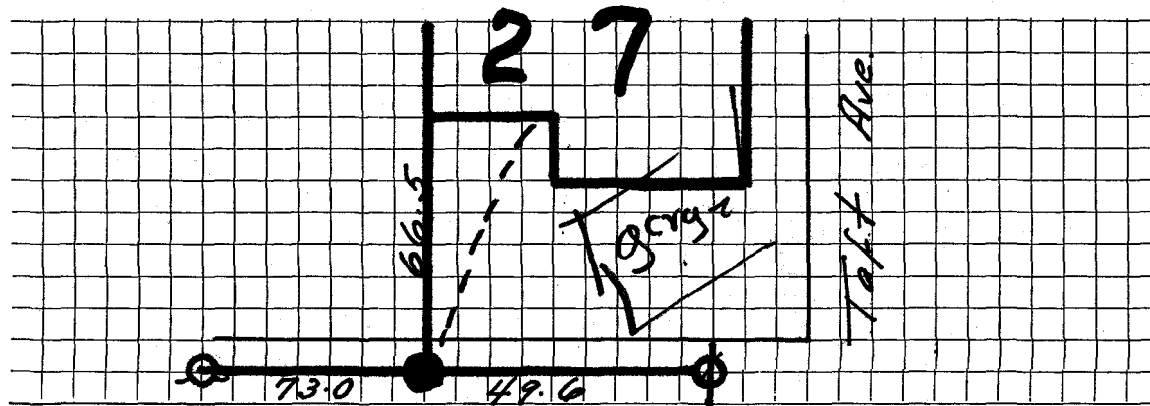

Connection made in Sutherland Street. Feb. Work completed _____ 19

Remarks: