

Name Lexington Homes, Inc.

Service No. ~~112~~ 2645

Address Lexington, Mass.

*28 Taft Ave*

Location 28 Taft Avenue

Kind of Pipe

Size

Size of Main

Repair—Renewal—New Service

Location

Date 1941	Material	Amount	Total	Date	Amount
September	2 hrs. @ 60¢	1 20		<i>Nov. 19, 1941 Paid</i>	11 21
<i>Com 10/13/41</i>	10% Overhead	12	1 32		
	31' 3/4" Copper tubing @ 19¢		5 89		
	1 3/4" C. S. & W.		2 50		
	Trucking, 2 hrs. @ 75¢		1 50		
			11 21		
				<i>Oct 28, 1941 Bill sent -</i>	
	Labor				

Hadley Press, Inc., Lexington

# TOWN OF LEXINGTON—BOARD OF PUBLIC WORKS

## WATER DIVISION

The undersigned applies for a supply of water at No. 28 Taft Avenue St. and hereby agrees to comply with the rules and regulations as now, or at any future time, established by the Board of Selectmen.

Am't. of Estimate \$ 15-

Owner

Leungton Haines, Inc.


Am't. Paid \$ \_\_\_\_\_

Address

57 Bedford Street  
Lexington, Mass.

Builder \_\_\_\_\_

Sketch of Service Here

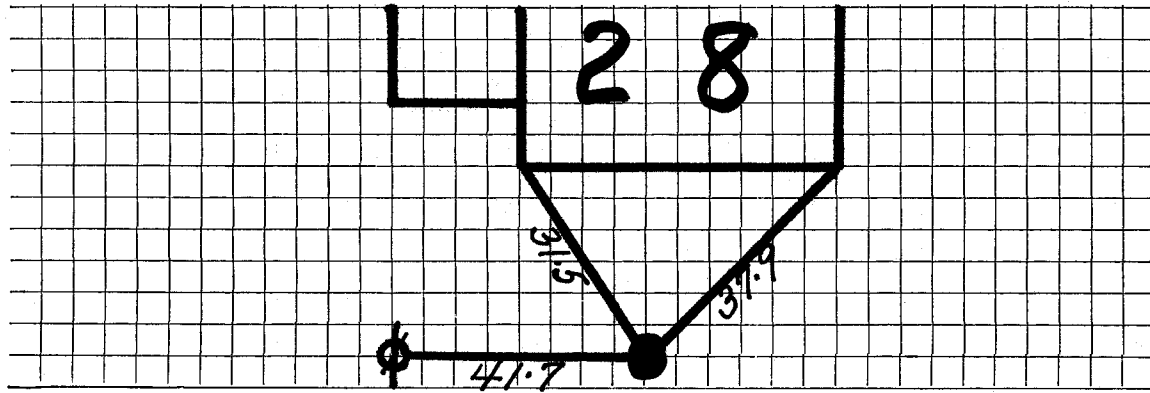

Connection made in \_\_\_\_\_ Street.

Work completed \_\_\_\_\_ 19

Remarks: