

Name Waverley Construction Company

1025

Service No. 69 3170

Address 30 Taft Avenue

Lexington, Mass.

Location 30 Taft Avenue

Kind of Pipe

Size

Size of Main

Repair—Renewal—New Service

Location

Date	Material	Amount	Total	Date	Amount
Aug. 23, '46	Labor	90	90	Aug 6 '46	Deposited 15 00
	10% Overhead		09	Nov. 29 '46	Refunded 3 94
	34' - 1/4" Copper Tubing @.1911	6 50			Non-Charge 11 06
	1 - 1/4" C x 1/2" I.W.H. Stop & Waste	2 82		Aug. 23, '46	Labor 90
	Trucking 1 hr. @.75		75	15' - 3/4" Copper tubing @.1911	2 87
			11 06	1 - 3/4" C. Corp-cock	2 70
	<u>Trench Dug By Owner</u>			1 - 3/4" C x 3/2" C Curb-cock	3 30
				1 - Box & Rod	1 65
				1 - 1/2" Straight Tail Piece	90
				1 - 1/2" Offset Tail Piece	90
				Trucking 1 hr. @.75	75
					<u>13 97</u>
	<b>Labor</b>				

Hadley Press, Inc., Lexington

DATE \_\_\_\_\_

# TOWN OF LEXINGTON—BOARD OF PUBLIC WORKS

## WATER DIVISION

The undersigned applies for a supply of water at No. \_\_\_\_\_ St. and hereby agrees to comply with the rules and regulations as now, or at any future time, established by the Board of Selectmen.


Am't. of Estimate \$ \_\_\_\_\_

Owner \_\_\_\_\_

Am't. Paid \$ \_\_\_\_\_

Address \_\_\_\_\_

Builder \_\_\_\_\_

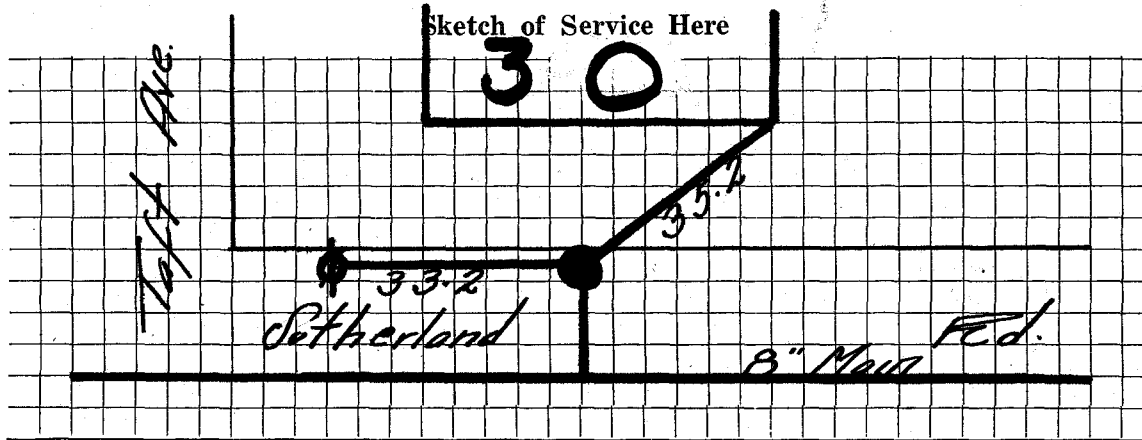

Connection made in \_\_\_\_\_ Street.

Work completed \_\_\_\_\_ 19

Remarks: