

	•	
DATE		

TOWN OF LEXINGTON-BOARD OF PUBLIC WORKS

WATER DIVISION french

St. and hereby agrees to The undersigned applies for a supply of water at No. #7 comply with the rules and regulations as now, or at any future time, established by the Board of Selectmen.

Am't. of Estimate \$ 19.00


Am't. Paid \$_____

Builder

Owner

Address

Sketch of Service Here

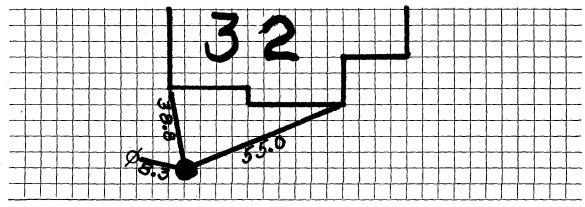

Connection made in

Street.

Remarks: