

Name James Irwin

Service No. 3244 ✓

Address 33 Taft Avenue

4913
6161

Lexington, Mass.

Location 33 Taft Avenue

Kind of Pipe

Size

Size of Main

~~REPAIR WORK~~ — New Service

Location

Date	Material	Amount	Total	Date	Location	Amount
June 2, '47	Labor	3 80		Dec 9 '46	Deposited	15 00
3	"	<u>1 05</u>	4 85	Sept 22 '47	Paid	<u>2 88</u>
	10% Overhead		49		Non-Charge	17 88
	32' - 3/4" Copper Tubing @.27		8 64	June 2, '47	Labor	7 60
	1 - 3/4" C x 1/2" I.W.H. S & W		3 15	3	"	12 87
	Trucking 1 hr. @.75		<u>75</u>	12' - 3/4" Copper Tubing @.27		3 24
			17 88	1 - 3/4" C Corp-cock		3 00
				1 - 3/4" C x 3/4" C Curb-cock		3 68
				1 - Box & Rod		4 28
				1 - 1/2" Straight Tail Piece		30
				1 - 1/2" Offset Tail Piece		30
				Trucking 1 hr. @.75		<u>75</u>
	Labor					36 00

Bill send 9.16.47

Hadley Prefs, Inc., Lexington

DATE _____

TOWN OF LEXINGTON—BOARD OF PUBLIC WORKS

WATER DIVISION

The undersigned applies for a supply of water at No. _____ St. and hereby agrees to comply with the rules and regulations as now, or at any future time, established by the Board of Selectmen.

Am't. of Estimate \$ _____

Owner _____


Am't. Paid \$ _____

Address _____

58 Taft Avenue

Builder _____

Sketch of Service Here

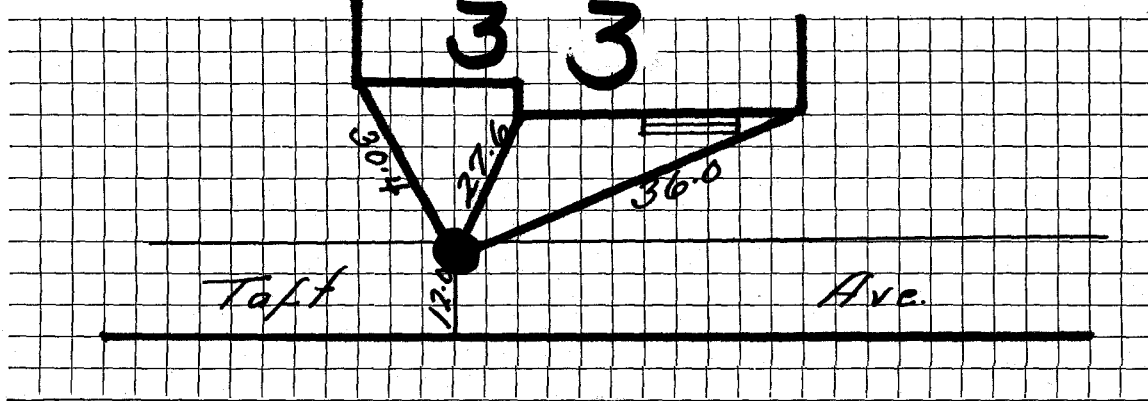

Connection made in _____ Street.

Work completed _____ 19

Remarks: