

WATER SERVICE RECORD

Name Michael Cerula

Service No. 188

Address 34 Taft Ave.

2098

Location

~~REPAIR WORK~~ - New Service

Com. 8-31-53


Date	Material	Amount	Total	Date	Amount
8/3/53	Labor	1 75		7-6-53	Deposited 25 00
	10% overhead	18	1 93	8-31-53	Paid 2 37
	57' - 3/4" copper tubing@.3629		20 69		<u>NON CHARGE</u> 27 37
	1 -3/4"C x 1/2 I.W.H.stop& waste		4 00	8/3/53	Labor 1 75
	1 hr. trucking		75	19' -3/4" copper tubing@.3629	6 90
			27 37	1 - 3/4" C. corp-cock	4 33
				1 - 3/4" C x 3/4"C. curb-cock	4 67
				1 box and rod	3 90
				1 -1/2 straight tail pc.	50
				1 -1/2 offset tail pc.	50
				1 hr. littlefield shovel	7 50
				1 hr. trucking	75
					<u>30 80</u>

DATE _____

TOWN OF LEXINGTON — BOARD OF PUBLIC WORKS

WATER DIVISION

Sketch of Service Here

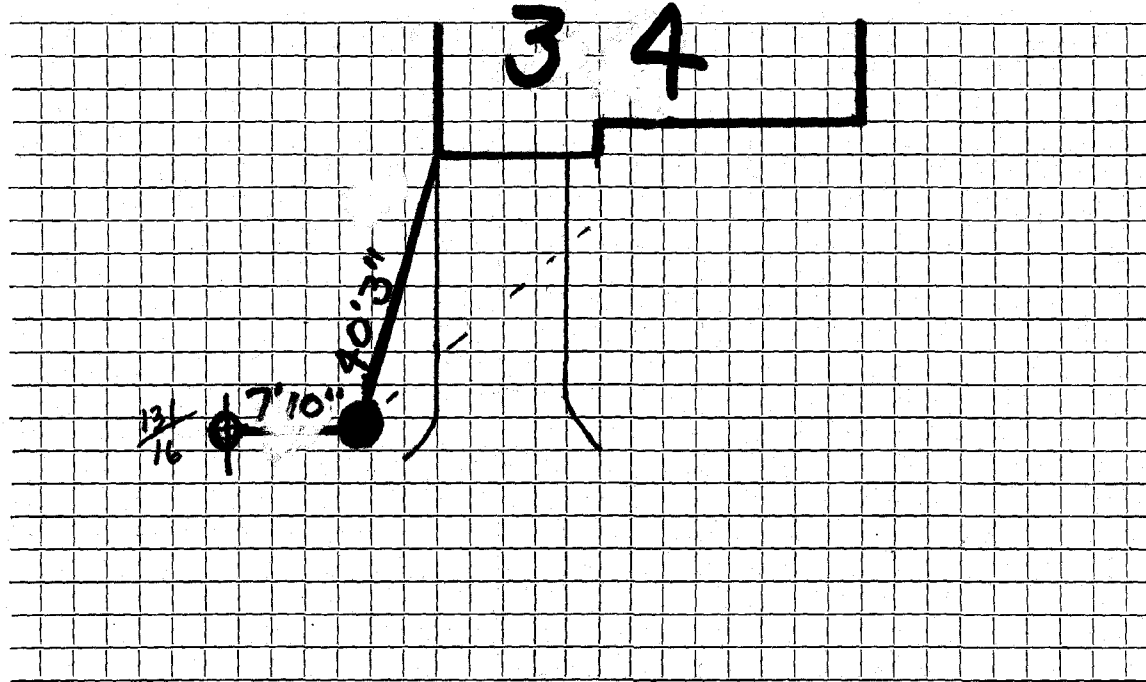

Connection made in Street. Work completed

Remarks:

.....

.....