


DATE 1/6/94

TOWN OF LEXINGTON — BOARD OF PUBLIC WORKS

WATER DIVISION

Sketch of Service Here

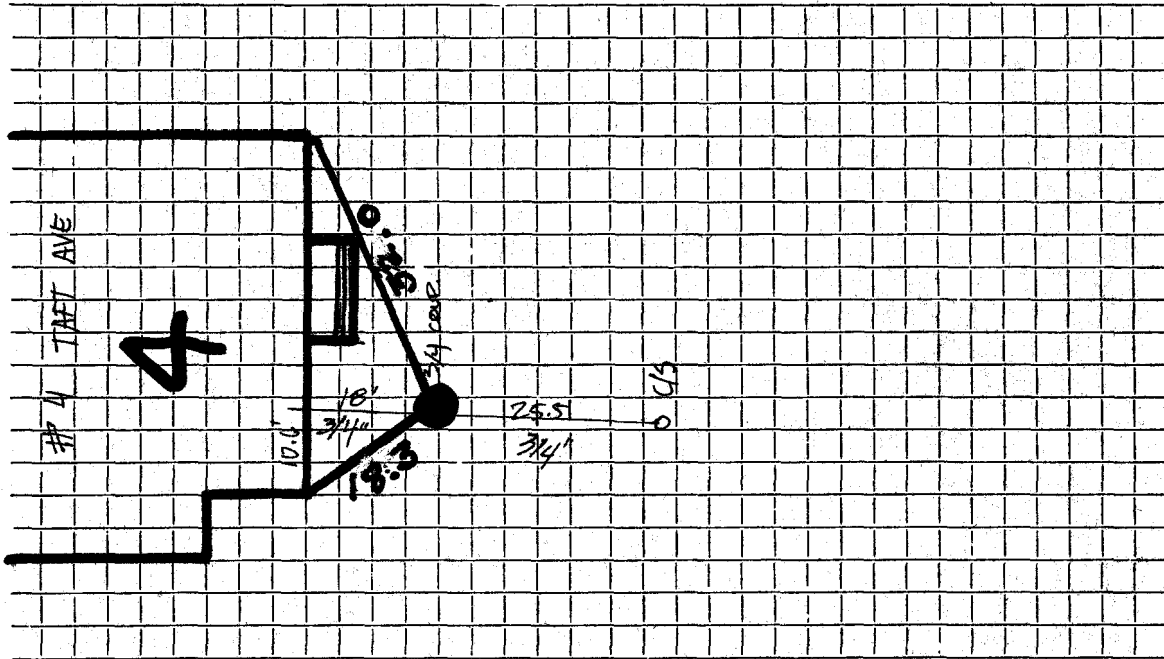

Connection made in Street. Work completed 2/6/93 B. MCKEE.....

Remarks: Original Service 9-4-34.....