

Name W. R. Colwell

Service No. 2648

Address 25 Bradford Rd., Watertown

Location #40 Taft Ave. Lot #207

2519
#6427
#6440

Kind of Pipe

Size

Size of Main

~~Repair & Renewal~~ - New Service

Location

| Date | Material | Amount | Total | Date | Amount |
|---------------------------|-------------------------|---------|---------|-------------------------------|--------|
| 1.4.14.31 for 22.50 | 30' 1" C.L. Pipe @ .27 | 8 10 | | | |
| | 2 1" L.L. Coup. @ .30 | 60 | | | |
| | 2 1" L.L. ELIs @ .35 | 70 | | | |
| | 3 1" Br. Sp. Nip. @ .25 | 75 | | | |
| | 1 S & W | 3 00 | | | |
| | Trucking | 75 | 13 90 | | |
| 3/23/31 | 7 Hrs. Labor @ .55 | 3 85 | | March 18 1931 - Cash | 22 50 |
| | 2 " " @ .60 | 1 20 | 5 05 | | |
| | 15% Overhead | | 76 | Checked Outside 3/4 Copper | |
| | COST | | 19 71 | | |
| | Labor | | | | |
| CHARGE | 30' @ .75 | \$22 50 | \$22 50 | | |

Hadley Press, Inc. Lexington

DATE Mar 2

TOWN OF LEXINGTON—BOARD OF PUBLIC WORKS

WATER DIVISION

The undersigned applies for a supply of water at No. 74 Highland St. and hereby agrees to comply with the rules and regulations as now, or at any future time, established by the Board of Selectmen.

Am't. of Estimate \$ _____

Owner W. K. Small


Am't. Paid \$ _____

Address 90 Bradford St.

Builder _____

40 TAFT

Sketch of Service Here

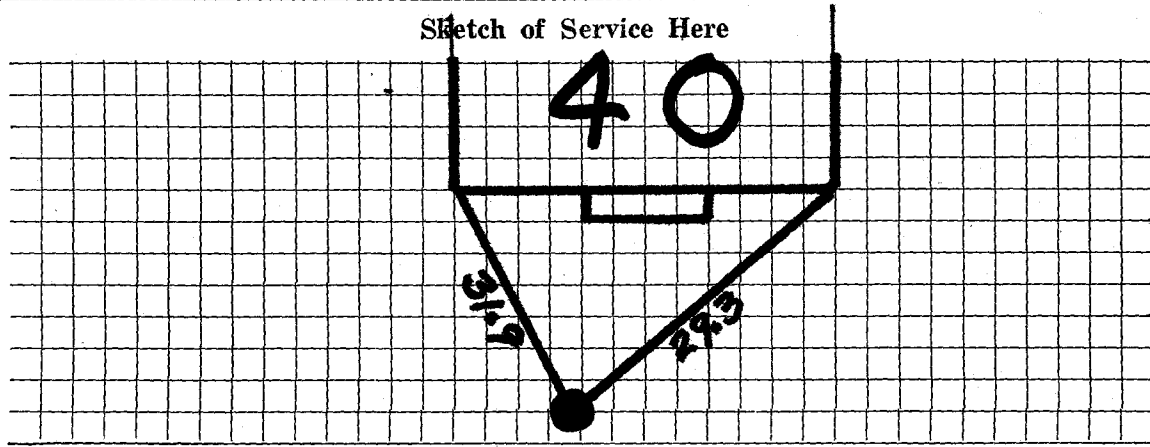

Connection made in _____ Street.

Work completed _____ 19

Remarks: