

Name Harry E. Johnson

Service No. 2627

Address 1070 Mass. Ave., Arlington

#5 Taft Ave.

#5884

7 5 Taft Ave

Location

Lot # 42 Taft Avenue

Kind of Pipe

Size

Size of Main

~~Repair-Renewal~~ New Service

Location

Date	Material	Amount	Total	Date	Amount
9/3/34	36' 1" C.L. Pipe	\$9 72			
<i>12-31-34 Com. 10.86 to Russell</i>	1 1" L.L. Ell	30			
	1 1" Br. Sp. Nip.	25			
	1 S & W	2 75			
	Trucking	75	13 77		
	3 Hrs. Labor @ .60	1 80			
	2 " " @ .55	1 10	2 90		
	10% overhead		29		
	<u>Cost</u>		16 96		
	<u>Charge</u> 36' @ .30	\$10 80	\$10 80		
	Labor				
	Est. of .30 per ft. based on using 3/4" copper tubing, but as no copper t. was on hand, used c. l. pipe.				
				Aug. 25 1934 - Reprinted	10 50
				checked outside	
				3/4 Copper	

Hay Press, Inc., Lexington

30¢ per ft.

DATE Aug. 24, 1934

TOWN OF LEXINGTON—BOARD OF PUBLIC WORKS

WATER DIVISION

The undersigned applies for a supply of water at No. Lot #42 Taft Ave. St. and hereby agrees to comply with the rules and regulations as now, or at any future time, established by the Board of Selectmen.

Am't. of Estimate \$ 10.80


Owner Harry G. Johnson

Am't. Paid \$ _____

Address _____

Builder _____

Sketch of Service Here

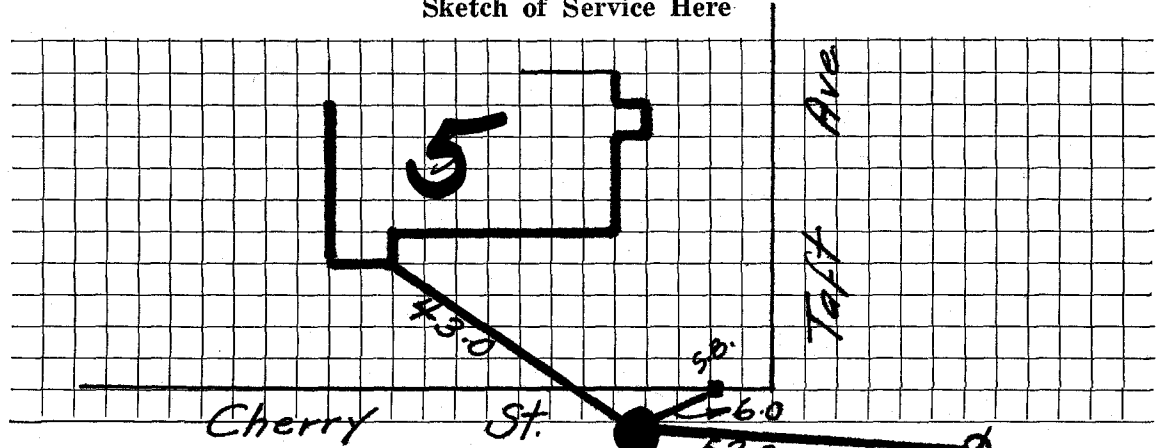

Connection made in _____ Street. 52.8 Work completed _____ 19

Remarks:

Water 36 ft