

WATER SERVICE RECORD

#4984

Name Malcolm Hodge

Service No. 78

Address 50 Taft Avenue

Location Lexington, Mass.

~~Repair - Removal~~ New Service


Com. 8-6-51

Date	Material	Amount	Total	Date	Amount
5-18-51	Labor	1 49	1 49	May 1 51	20 00
	10' Overhead		15		
	30' - 3/4" Copper Tubing @ .326		9 78		No Charge
	1 - 3/4" x 1/2" I. W.H. S&W		4 00	5-18-51	Labor
	Trucking 1 hr. @ .75		75		1 49
			16 17	24' - 3/4" Copper Tubing @ .326	7 82
				1 - 3/4" Corp-cock	4 33
				1 - 3/4" x 3/4" Curb-cock	4 67
				1 - Box & Rod	4 68
				1 - 1/2" Offset Tail Piece	50
				1 - 1/2" Straight Tail Piece	50
				Trucking 1 hr. @ .75	75
					24 74

DATE _____

TOWN OF LEXINGTON — BOARD OF PUBLIC WORKS
WATER DIVISION

Sketch of Service Here

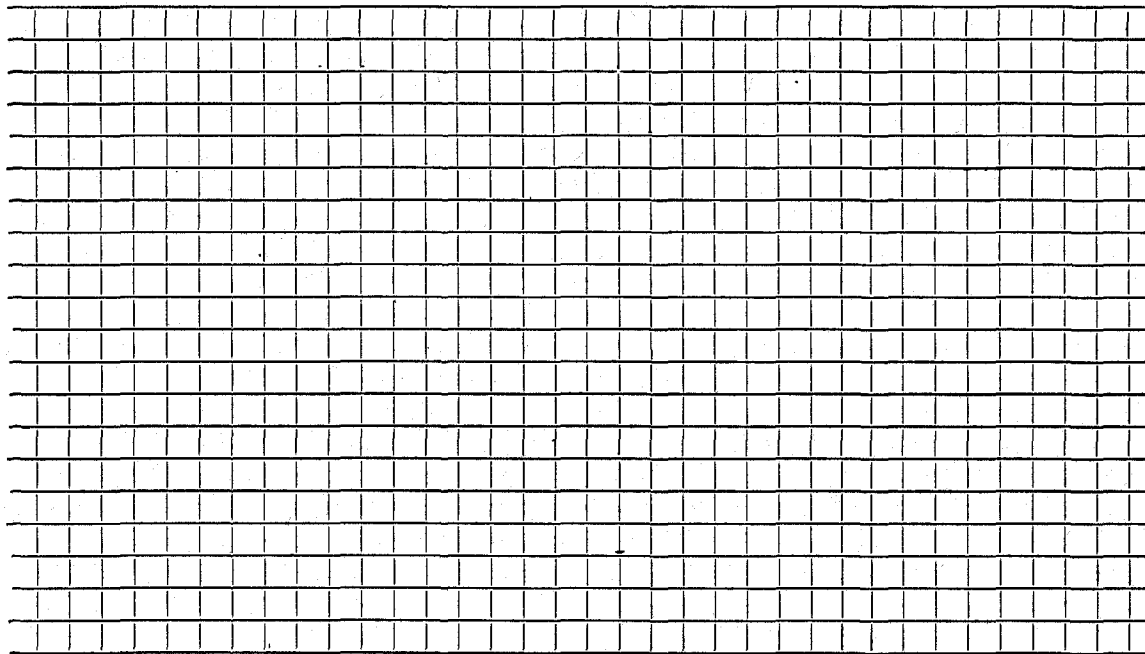

Connection made in Street. Work completed

Remarks:
.....
.....