

WATER SERVICE RECORD

Name Busa Realty

Service No. 46

Address 51 Taft Avenue

Location

~~Repair - Renewal~~ New Service

W. O. # 8360

DiFlax #1990

APR 26 1972


Date	Material	Amount	Total	Date	Amount
12/21/71	Labor	13 36		12-17-72	100 00
	10% O.H.	1 34	14 70	4-26-72	41 01
20'	3/4" Copper pipe	79	15 80	Returned	58 99
	3/4" Corporation		9 57		
	3/4" Curb stop		11 32		
	Box & Rod		7 60		
			58 99		
1-5-72	33' 3/4" Copper tubing				

DATE _____

TOWN OF LEXINGTON — BOARD OF PUBLIC WORKS

WATER DIVISION

Sketch of Service Here

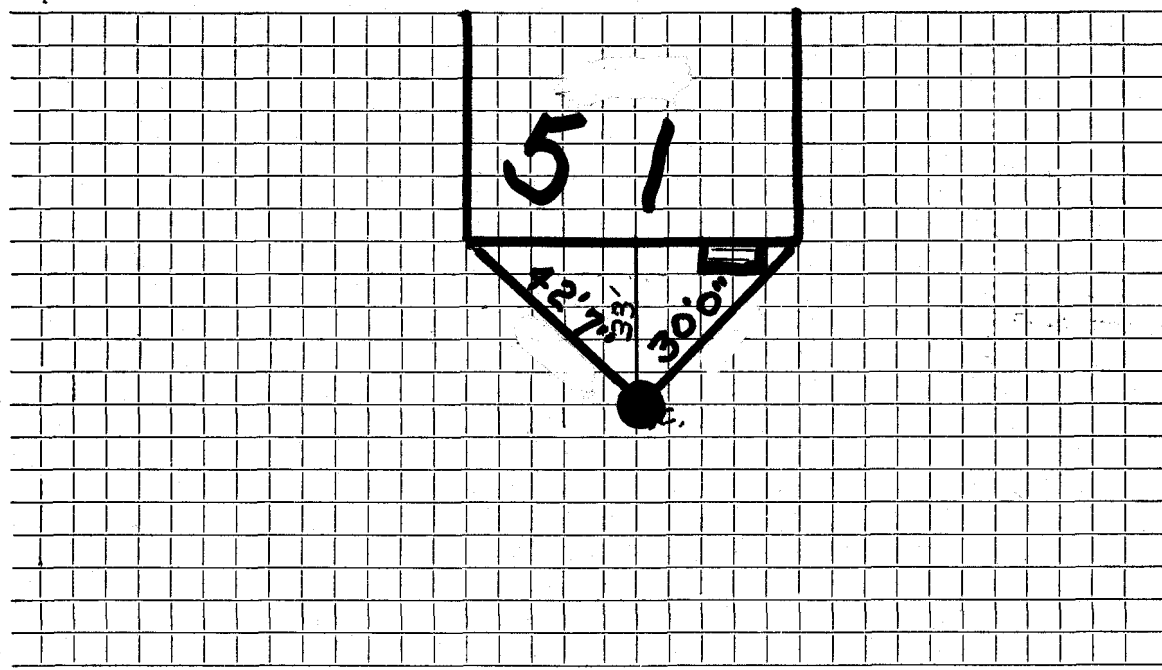

Connection made in Street. Work completed

Remarks:
.....
.....