

Name Edward E. Coye, Jr.

Service No. ~~18~~ 2650

Address 53 Taft Avenue, Lexington, Mass.

Location

Kind of Pipe

Size

Size of Main

~~Repair—Renewal—New Service~~

Location

Date 1943	Material	Amount	Total	Date	Amount
July 12,	8 hrs. @ 65¢	5 20		<i>JUN. 21. 1943</i>	12 00
<i>Sum 7/16/43</i>	1 hr.	70		<i>July 28. 1943</i>	1 55
	1 "	80	6 70		<u>10 47</u>
	10% Overhead		67		
	1 3/4" Cx3/4" I.W.H.S.& W.		2 35		
	1 hr. trucking		75		
			<u>10 47</u>		
Note: Pipe from curb to house supplied by owner)					
Non chargeable : Labor			10 60		
	7 ' 3/4" Copper tubing @ 21¢		1 47		
	1 3/4" Adapter		1 00		
	1 3/4" C. curb cock		2 75		
	1 box & rod		1 65		
	1 hr. trucking		75		
	Labor		<u>\$18 22</u>		

*Deposited*  
*Refund*

Hadley Press, Inc., Lexington

DATE June 21, 1943

# TOWN OF LEXINGTON—BOARD OF PUBLIC WORKS

## WATER DIVISION

The undersigned applies for a supply of water at No. 53 Taft Ave St. and hereby agrees to comply with the rules and regulations as now, or at any future time, established by the Board of Selectmen.

Am't. of Estimate \$ 1200.

Am't. Paid \$ \_\_\_\_\_

Builder \_\_\_\_\_

Owner


Edward E. Roy, Jr.

Address

53 Taft Ave.

Lexington Mass.

Sketch of Service Here

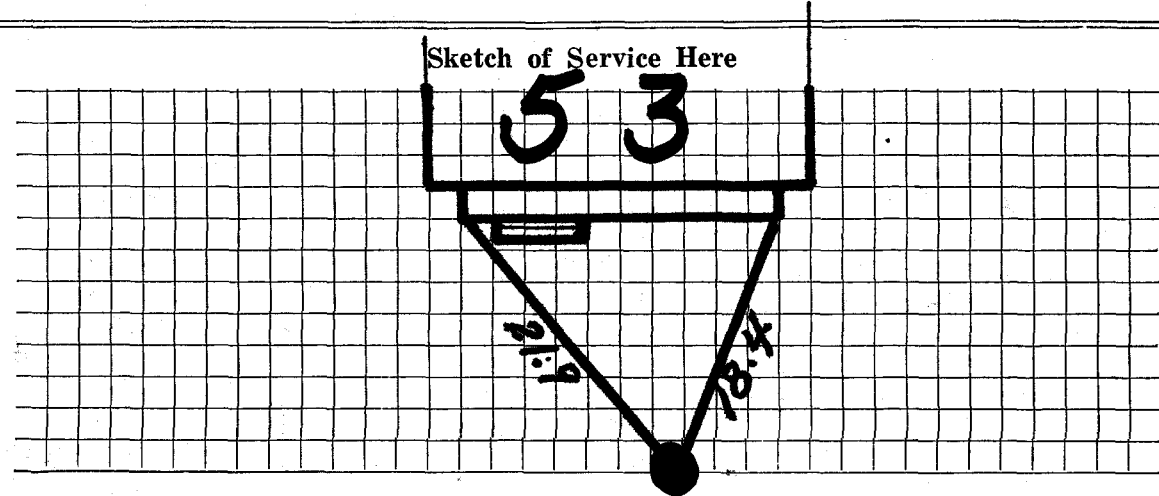

Connection made in \_\_\_\_\_ Street.

Work completed \_\_\_\_\_ 19

Remarks: