

WATER SERVICE RECORD

6144

Name Andrew T. Hartery, Jr.

Service No. 78

Address 54 Taft Avenue

3693

Location

~~Renewal~~ Renewal ~~W.O. #5852~~ W.O. #5852

AUG 5 1968


Date	Material	Amount	Total	Date	Amount
12/18/67	Labor	94 64		11-13-67	Deposit 200 00
	10% O.H.	9 46	104 10	3-5-68	Refund 46 88
	1/4" 3/4" Copper tubing @ .79		34 76		153 92
	1 3/4" Wheel Valve		9 30		OUTSIDE
	1 3/4" Adapter		2 76	12/19/67	Labor 121.36
	1 Hr. Trucking		3 00	3/27/68	Labor 33.14
			153 92		154 50
				21'	3/4" Copper tubing @ .79 16 59
				1	3/4" curb cock 11 32
				1/2	Ton Cold Patch @ 5.50 2 75
				1/2	Roll insulation 2 50
				2	Ton hot top @ 5.80 11 60
				3 1/2	Hrs. Trucking @ 3.00 10 50
				2	Hrs. Shovel @ 6.50 13 00
				1	Hr. Compressor 5 00
				1/2	Hr. Roller & trailer 3 50
					231 26

DATE _____

TOWN OF LEXINGTON — BOARD OF PUBLIC WORKS

WATER DIVISION

Sketch of Service Here

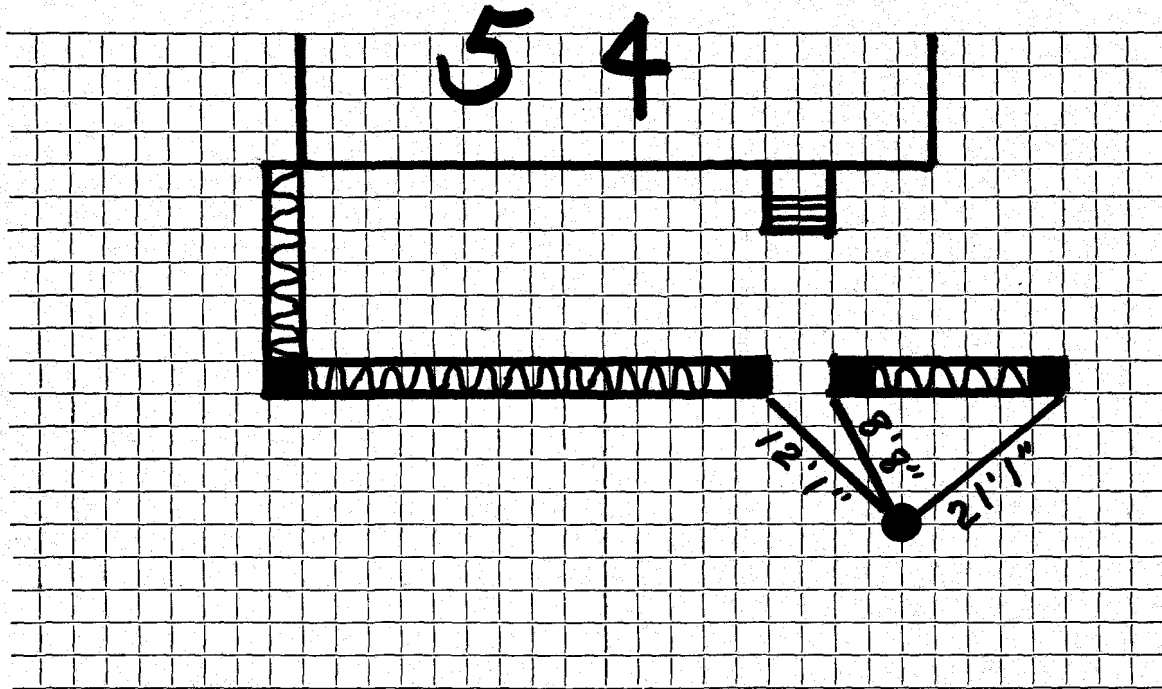

Connection made in Street. Work completed

Remarks:
.....
.....