

Name Donald Irwin

Service No. 1413 8388

Address 55 Taft Avenue

Location 55 Taft Avenue

Kind of Pipe

Size

Size of Main

New Service

Com 12-1-47

Location

Date	Material	Amount	Total	Date	Amount
Oct. 17, '47	Labor	1 05	1 05	Oct 14 '47	15 00
	10% Overhead		11	Dec 4 '47	1 62
	32' - 3/4" Copper Tubing @.26	8 32	8 32		13 58
	1 - 3/4" C x 1/2" I.W.H. S & W	3 15	3 15		
	Trucking 1 hr. @.75		75		
			13 38		
				Oct. 17, '47	1 05
				9' - 3/4" Copper Tubing @.26	2 34
				1 - 3/4" C Corp-cock	3 00
				1 - 3/4" C x 3/4" C Curb-cock	3 68
				1 - Box & Rod	4 26
				1 - 1/2" Straight Tail Piece	30
				1 - 1/2" Offset Tail Piece	30
				Trucking 1 hr. @.75	75
					15 69
	Labor				

DATE _____

TOWN OF LEXINGTON – BOARD OF PUBLIC WORKS

WATER DIVISION

The undersigned applies for a supply of water at No..... St. and hereby agrees to comply with the rules and regulations as now, or at any future time, established by the Board of Selectmen.

Am't of Estimate \$.....


Owner

Am't Paid \$.....

Address

Builder

Sketch of Service Here

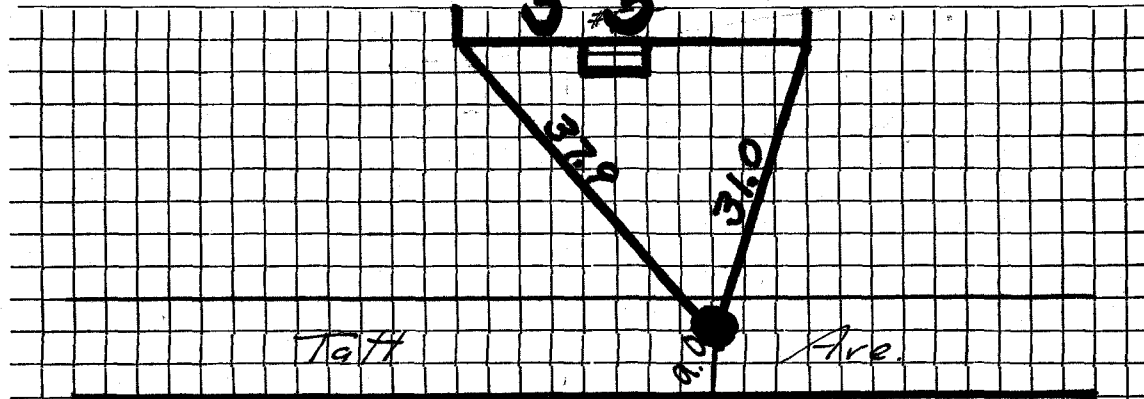

Connection made in Street.

Work completed19

Remarks: