

WATER SERVICE RECORD

5924

Name Frank DeFelice

Service No. 6

Address 57 Taft Avenue

Location Lexington, Mass.

~~Repair-Renewal-New Service~~

Com. 5-21-51


Date	Material	Amount	Total	Date	Amount
3-10-51	Labor	14 25	14 25	Jan 5 51	Deposited 35 00
	10% Overhead		1 43		
	23' - 3/4" Copper Tubing @.36		8 28		No Charge 28 71
	1 - 3/4"C x 1/2" I.W.H. S&W		4 00	3-10-51	Labor 24 25
	Trucking 1 hr. @.75		75		15' - 3/4" Copper Tubing @.36 5 40
			28 71		1 - 3/4"C Adapter 1 82
					1 - 3/4"C x 3/4"C Curb-cock 4 33
					1 - 1/2" Offset Tail Piece 50
					Littlefield Shovel 2 hrs. @ 7.00 14 00
					Trucking 1 hr. @.75 75
					Patching 12 x 3 12 00
					63 05

DATE _____

TOWN OF LEXINGTON — BOARD OF PUBLIC WORKS

WATER DIVISION

Sketch of Service Here

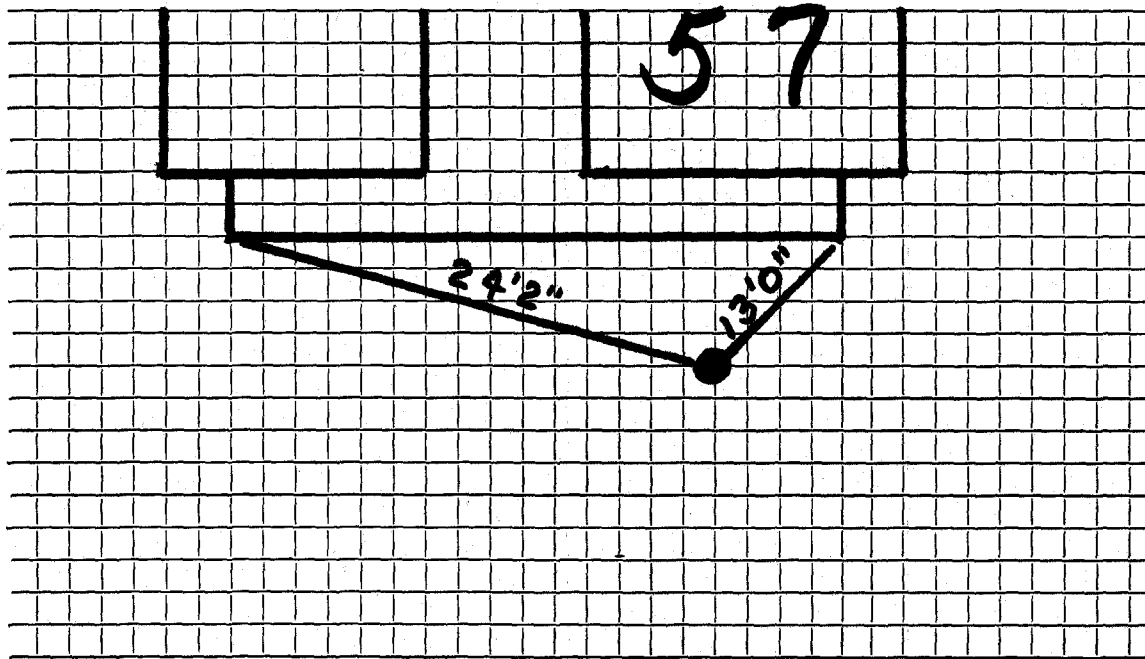

Connection made in Street. Work completed

Remarks:

.....
.....